


KANSAS

FORM 51 5M PETROL

Section 3 Township 9 Range 19W

Well No. 1 Novotny

Company Continental

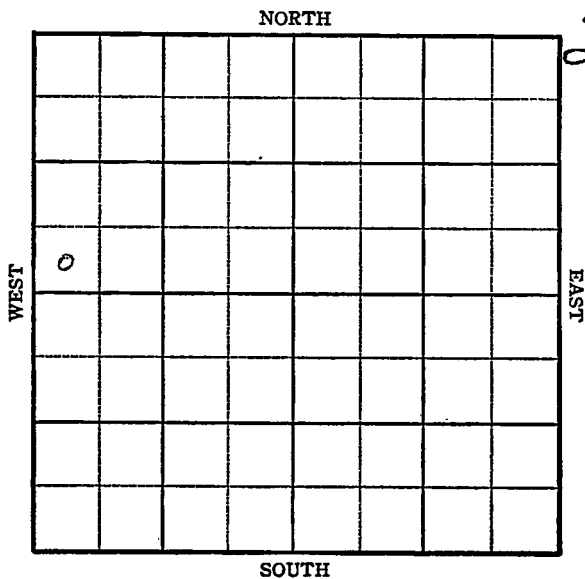

Sec. 3 Twp. 9 R. 19-W


Well No. #1 Novotny Farm _____
Continental Company _____

_____ Ft. from N. Line

330 Ft. from S. Line

_____ Ft. from E. Line

330 Ft. from W. Line

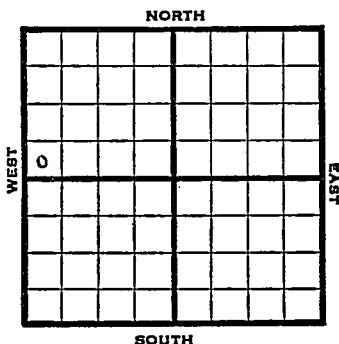

SW NW

1945 Elev. 1991 REPORT

11/7 Derrick

11/14 RUR "

11/21 10" @ 240

Drig. 2615'

11/28 Lans 3178

Arb. 3445

TD 3452

6" @ 3446 RUST

12/5 " " "

12/12 TD 3499

54 shots 3356-3404 1000 acid.

Swb. 10 gals. oil plus 5 gal. WPH

8 hrs.

12/19 Lans 3178

Arb. 3445

6" @ 3446

Perf. Lans 4000 acid.

TD 3452'

ABANDONED

KANSASKansas Pool Name BarryMap No. 65 Sec. 3 Twp. 9 R. 19WWell No. 1 Novotny

Continental

Company

FIRST REPORT

Contractor

SW NW

SECTION PLAT

_____ Ft. from N. Line

330 Ft. from S. Line

_____ Ft. from E. Line

330 Ft. from W. Line

8			

Rooks County

Location _____

Rig up _____

Drilling and Remarks:

derrick

RECORD

Cased _____ in., _____ ft.

Sand _____

Gas _____

Oil _____

Total Depth _____

PRODUCTION

1st 24 hrs. Nat. _____

1st 24 hrs. after shot _____

Gas _____ Cu. Ft.

Dry Hole _____

Abandoned _____

Date

NOV 7 1945 19

S. J. LEWIS

Scout

