

Graham KANSAS

Well No. 1 Tremblay

Company R. W. Shields

WEST

EAST

**SOUTH**

# Graham KANSAS

|      |      |     |
|------|------|-----|
| SEC. | TWP. | R.  |
| 3    | 9    | 21W |

WELL NO.

1 Tremblay

FARM

COMPANY

R. W. Shields

CONTRACTOR


Empire  
Wildcat

330 Ft. from N. Line

Ft. from S. Line

Ft. from E. Line

330 Ft. from W. Line

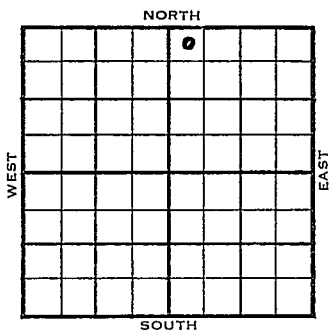

NW NW NE

Phillips DHM

|      | ELEVATION   | REPORT |
|------|---|--------|
| 1955 | <del>2182</del> 2129'   |        |
| 4/20 | 8" @ 170'   |        |
| 5/25 | <del>Top 3182; Heeb 3182; Tor 3182;<br/>Isgr 3142; Congl 3855; Arb 3882;<br/>TD 3230; 8 5/8" 181; DST 3625-55<br/>xxx open 30 min; rec 53 com; d 40#<br/>B&amp;Axx</del>   |        |
| 5/25 | Heeb 3287; Tor 3317; Isgr 3327; B.K.C. 3541; Marm 3561; Congl 3667; Arb 3707; TD 3755 8" 170; DST 3320-45 open 1 hr, rec 25' so and gcm, 60' oil and gcmw, 1200#; DST 3662-74 open 1 1/2 hr, rec 360' oil, 830#; 5 1/2" 3754; CO; 20/3667-72; test 2 boph 100 A; swb 1 1/4 boph no wtr 12 hrs; swb 1 1/2 boph no wtr 1 hr; Phy pmp 73 bopd no wtr from Congl 3667-72 |        |

COMPLETED

