


DX 78-1 GRAHAM

KANSAS

Section 3 Township 9 Range 24W

Well No. 3 Ida Keith

Company Empire Drlg.

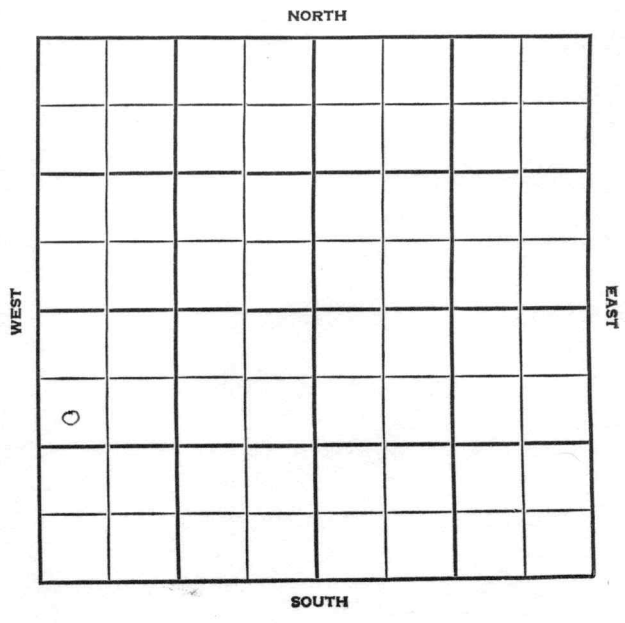

Graham

KANSAS

SEC.	TWP.	R.
3	9	24 W

WELL NO.

3 Ida Keith

FARM

COMPANY

Empire Drlg.

CONTRACTOR

Co. tools

Holly Pool

990

Ft. from N. Line


Ft. from S. Line

Ft. from E. Line

330

Ft. from W. Line

SW NW SW

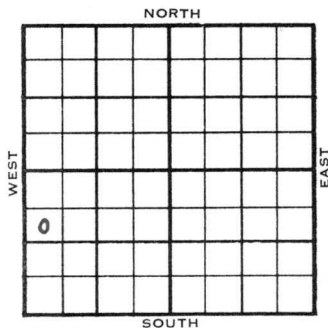

1955

ELEVATION

2432'

REPORT

3/30

Spud 3-28-55
8" @ 189 WOC

