


Section 3 Township 9 Range 24 WWell No. #5 Ida KeithCompany Empire Drlg.

NORTH

WEST

EAST

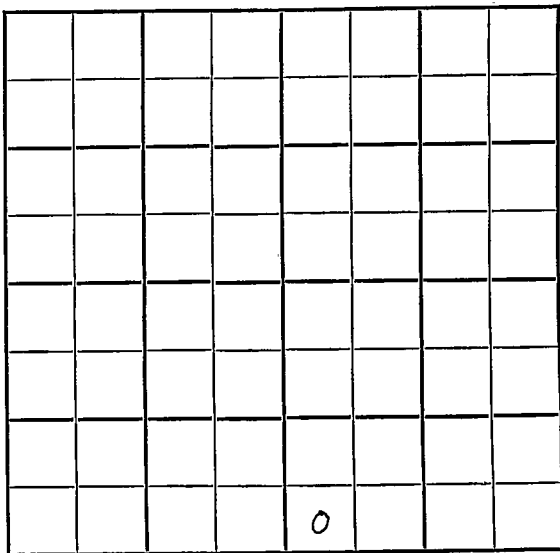

SOUTH

Graham

SEC. 3	TWP. 9	R.. 24W
-----------	-----------	------------

WELL NO.

#5 Ida Keith

FARM

COMPANY

Empire Drlg.

CONTRACTOR

Co. Tools

Holly


_____ Ft. from N. Line

_____ Ft. from S. Line

_____ Ft. from E. Line

_____ Ft. from W. Line

SW SW SE

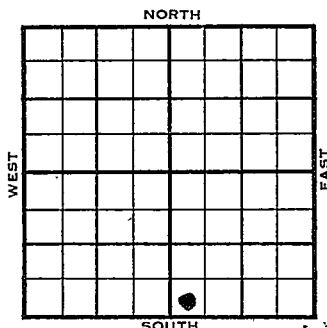

1955	ELEVATION	REPORT
8/3	Location	FIRST REPORT
9-7	8 5/8" @ 171/115	
	DST 3786-3809, open 1 hr. rec. 210' GIP	
	630' vhocm, 540' gassy salt water 1300#	
	DST 3835-50, open 1 hr., rec. 840' GIP	
	25' oil 210' vhocm 120' wtr., 1080#	
	DST 3897-3925, open 1 hrs, rec. 1740'	
	GIP 365' oil 20' vhocm 1030#	
	TD 3960	
	5 1/2" @ 3953/75 24/ 3935-41 2000 A	
	S/ 28 boph 8 hr.	
	Comp. 250 bopd	
	<u>Tops</u>	<u>Depth</u>
	Anh	2120
	H.	2729
	Tr.	3755
	L.	3769
	T.D. 3960'	
		COMPLETED

Co.

L5e.

FBI REPORT		No.
AUG 3 '55	0	

No.

See:

4

३५

County Graham Elev. 2440
 Sec. 3 Twp. 9 Rge. 24W
 Company Empire Drlg.
 Farm Name Ida Keith No. 5

TOPS	DEPTH	LOG	DATUM	Loc. in Sec.
Anh.	2120			SW SWSE
Tr.				
H.	2729		1289	
Tr.	3755		1315	
Dg.				
Bl.				
L.	3769		1329	Geol.
K.C.				Contr.
B.K.C.				
Ce.				Co. tools
C.				Pool
M.				Holly
M.				
K.				
Mz.				
Mq.				
V.				
S.				
S.				
A.				
R.				
Pe.				
G.				
TD.	3960			

COMPLETE

Date Comm. 8-7-55 SEP 7 1955

8 5/8" @ 171/115 DST 3786-3809

open 1 hr. rec. 210' GIP 630' whocm

540' gassy salt water 1300# DST 3835-50

open 1 hr. Rec. 840' GIP 25' oil

210' whocm 120' wtr. 1080# DST 3897

3925 open 1 hr. Rec. 1740' GIP

365' oil 20' whocm 1030# TD 3960

OVER

5 $\frac{1}{2}$ " @ 3953/75 24/ 3935-141 2000 A
s / 28 boph 8 hr. Comp. 250 bopd

Scout Cards	✓
Land Small Map	
Land Wall Map	
Tracings	
France Map	
Piece Map	
Misc.	

SEP 15 1955