

Graham


KANSAS

SECTION 3 TOWNSHIP 9 RANGE 24 W

WELL NO. #6 I. Keith

COMPANY Empire Drlg.

NORTH

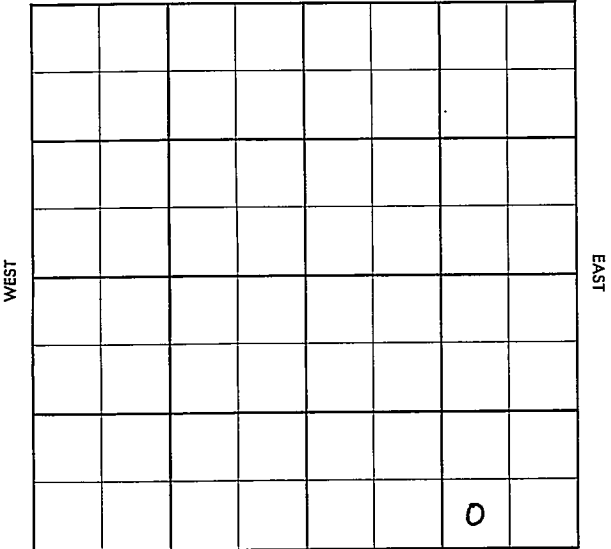

SOUTH

Graham

KANSAS

SEC.	TWP.	R.
3	9	24 W

WELL NO.

6 I. Keith

FARM

COMPANY

Empire Drlg.

CONTRACTOR

Co. tools

Holly


_____ Ft. from N. Line

_____ Ft. from S. Line

_____ Ft. from E. Line

_____ Ft. from W. Line

SW SE SE

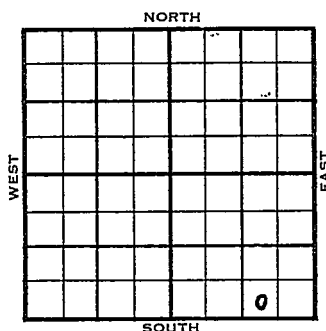

SDX - Offset

	ELEVATION	REPORT
1955	2413'	
12/28	Comm. 12-21-55 8" @ 170/115 Drlg. 2995' Anh. 2097'	
1956		
1-6	Heeb. 3705 Lans. 3745 5 1/2" @ 3933, TD 3935'	
1-12	CO to 3930, 20/ 3914-20, 1 boph, 3000 A S/ 20 boph, 8 hr.s POP	
1-19	Waiting on potential	
1-26	No report	
2-1	Comp. 110- bopd TD 3935'	

COMPLETED

County Graham Elev. _____
 Sec. 3 Twp. 9 Rge. 24W
 Company Empire Drig.
 FarmName I. Keith No. 6


TOPS	DEPTH	LOG	DATUM	Loc. in Sec.
Anh.	2097			SW SE SE
Ip.				
H.				
Tr.				
Dg.				
BL.				
L.				Geol. _____
K.C.				Contr. _____
B.K.C.				Co. tools
Ce.				Pool _____
C.				Nolly
M.				
M.				
K.				
Mz.				
Ma.				
V.				
S.				
S.			Sur	offset
A.				
R.				
Pe.				FIRST REPORT
G.				DEC 28 '55
T.D.				0

Date Comm. 12-21-55
8" @ 170/115 drlg. 2995

55

County Graham Elev. 2113
 Sec. 3 Twp. 9 Rge. 24W
 Company Empire Drlg.
 Farm Name L. Keith No. 6

TOPS	DEPTH	LOG	DATUM	Loc. in Sec.
Anh.	<u>2097</u>			SW SE SE
Tp.				
H.	<u>3705</u>			
Tr.				
Dg.				
BL.				
L.	<u>3745</u>		<u>1332</u>	Geol.
K.C.				Contr.
B.K.C.				Co. tools
Ce.				Pool
C.				Holly
M.				
M.				
K.				
Mz.				
Me.				
V.				
S.				
S.				
A.				
R.				
Pe.				
G.				
T.D.	<u>3935</u>			

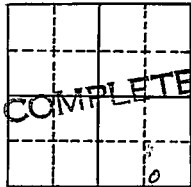

Date Comm. 12-21-55 FEB 1 1956
8" @ 170/115 5 1/2" @ 3933 C to 3930
20/ 3914-20 1 boph 3000 A
S/ 20 boph 8 hr. Comp. 110 bopd