

Section 3 Township 9 Range 30 WWell No. # 1 BoalmanCompany Victor Drlg.

NORTH

WEST								EAST
	0							

SOUTH

Sec. 3 Twp. 9 R. 30W

Well No. #1 Boalman Farm

Victor Drlg. Company

Victor Drlg. -Contr. Contractor

Wildcat


 Ft. from N. Line

330' Ft. from S. Line

 Ft. from E. Line

330' Ft. from W. Line


SW SW SW

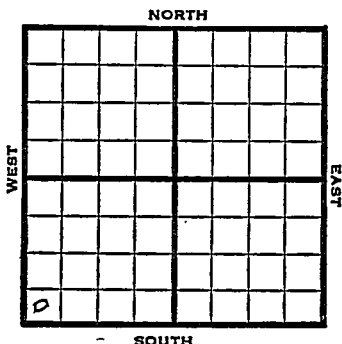

1952	Elev. 2942' REPORT
5/14	Spud 5-12-52 8" @ 290 WOC
5/21	Anhy 2575 Drlg. 3754'
5/28	Lans. 4001' DST 4038-53, 1/2 hr, 8' VSOCM 0# DST 4053-66, 3/4 hr, 85' VSOCM, 480' SW, 1340#. DST 4122-27', 3/4 hr, 30' VSOCM Drlg. 4618'
6/4	Spud 5-12-52 D&A TD 4644 8" @ 290 Anhy 2575 Lans. 4011 DST 4038-53 opn 1/2 hr. Rec. 8' vsocm DST 4053-66 opn 3/4 hr. Rec. 85' vsocm 480' sw DST 4122-27 opn 3/4 hr. Rec. 30' vsocm Heeb. 3980 Tor. 3995 Miss 4566 TD 4644 D&A
	ABANDONED



J. G. McGEHEE

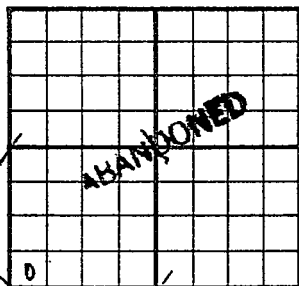County Sheridan State KansasSec. 3 (Blk. 9) (Sur. 30W) (Twp. 9) Map No.Operator Victor Drlg.Well No. 1 Farm BaalmannElev. 2942 Location SW SW SW330 Ft. From S Line SW330 Ft. From W Line Quarter

1st. Report

Completion JUN 4 1952Remarks WildcatVictor Drlg. - Contr.Spudding Date 5-12-52Drlg. Data D & A TD 46448" @ 290 Anhy 2575 Lans. 4011DST 4038-53 open $\frac{1}{2}$ hr. Rec. 8' vsocmDST 4053-66 open $\frac{3}{4}$ hr. Rec. 85' vsocm480' sw DST 4122-27 open $\frac{3}{4}$ hr.Rec. 30' vsocm Heeb. 3980 Tor. 3995Miss. 4566 TD 4644D & A