

Osborne

Form 51-5M-9-28-27423

Map No. KANSAS Sec. 30 Twp. 9 R. 14^w

Well No. 1- Irish Farm
Empire Oil & Refg. Company

NORTH

							0

WEST

EAST

SOUTH

Location.....

Drilling Remarks

.....

.....

RECORD

Cased..... in..... ft.

Sand.....

Gas.....

Oil.....

Total Depth.....

Rig Up.....

Drilling Remarks

.....

.....

PRODUCTION

1st 24 hrs. Nat.....

1st 24 hrs. after shot.....

Gas..... cu. ft.....

Dry Hole.....

Abandoned.....

Map No. KANSAS Sec. 30 Twp. 9 R. 14^W

Well No. 1- Irish Farm


Empire Oil & R. Company

_____ Ft. from N. Line

330 Ft. from S. Line

330 Ft. from E. Line

_____ Ft. from W. Line

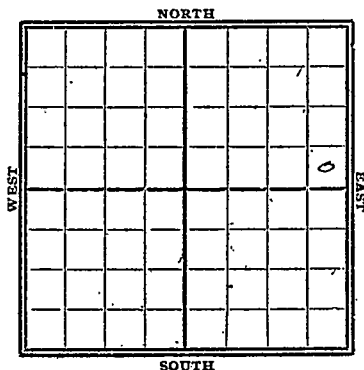

1928

Date	REPORT
12/12	Location
12/19	Bldg Rig
12/26	Rig
1929	
1/2	Rig up
1/9	
1/16	Spud
1/23	Spud 140'
1/30	drlg 600'
2/16	TD. 698'- Re-bldg rig - rig burned
2/13	
2/20	Rig up.
2/27	
3/5	drlg 855'
3/13	set 12" csg - 1170'
3/20	drlg 1170'
3/27	" 1745'
4/3	" 2625'
4/10	" 2915'
4/17	Top Oswald 3195' nearly show oil

- 4/24- Only 3200'
5/1 - U.R. 6" - 3310'
5/8 - U.R. 6" - 3517'
5/15 - 2 of chat 3560' T.D. 3604'
U.R. 6"
5/22 show oil 3676-80
5/29 - HFW 3733 Sil. lime at
3743-44 - only
6/5 - S.D. 3775'
6/12 - Silicious lime from
3743-75'
T.D. 3775'
Abandoned

Oxbone
 MAP NO. KANSAS SEC. 30 TWP. 9 R. 14W
No Map
 WELL NO. 1 *Oxide*

Empire Oil & Ref. COMPANY

CONTRACTOR

SECTION PLAT

			0

_____ FT. FROM N. LINE

330 FT. FROM S. LINE

330 FT. FROM E. LINE

_____ FT. FROM W. LINE

FIRST REPORTS

LOCATION ✓

RIG UP _____

DRILLING AND REMARKS:

RECORD

CASED _____ IN. _____ FT.

SAND _____

GAS _____

OIL _____

TOTAL DEPTH _____

PRODUCTION

1ST 24 HRS. NAT. _____

1ST 24 HRS. AFTER SHOT _____

GAS _____ CU. FT.

DRY HOLE _____

ABANDONED _____

DATE

DEC 7 1928

192

S. J. LEWIS

SCOUT

Map No. 63 **KANSAS** Sec. 20 Twp. 9 R. 14W

Well No. 1 Orient

Empire Oil & Ref. Company

Contractor

SECTION PLAT

..... Ft. from N. Line

330 Ft. from S. Line

330 Ft. from E. Line

..... Ft. from W. Line

ABANDONED

			0

Location.....

Rig up.....

Drilling and Remarks:

Sil line 3743

3775

LSH

RECORD

Cased..... in., ... ft.

Sand.....

Gas.....

Oil.....

Total Depth 3775

PRODUCTION

1st 24 hrs. Nat.....

1st 24 hrs. after shot.....

Gas..... Cu. Ft.

Dry Hole.....

Abandoned.....

Date

JUN 12 1929

192.....

S. J. LEWIS Scout