


Map No. KANSAS Sec. 30 Twp. 9 R. 15WWell No. 1- Pratter Farm
Pratter, Davis & Krueger Company

NORTH

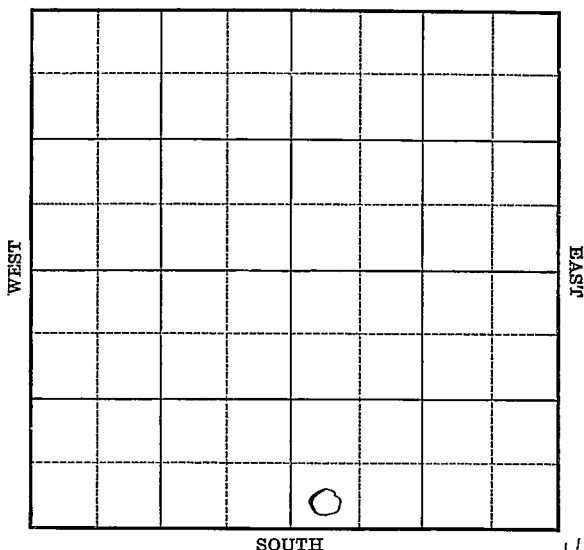

SOUTH

1605

Location _____

Drilling Remarks _____

Rig Up _____

Drilling Remarks _____

RECORD

Cased _____ in. _____ ft.

Sand _____

Gas _____

Oil _____

Total Depth _____

PRODUCTION

1st 24 hrs. Nat. _____

1st 24 hrs. after shot _____

Gas _____ cu. ft.

Dry Hole _____

Abandoned _____

Osborne

Map No. **KANSAS** Sec. **30** Twp. **9** R. **15 W**Well No. **1 - Pratter** Farm**Pratter, Davis, Truogel** Company

NORTH

_____ Ft. from N. Line

330 Ft. from S. Line

_____ Ft. from E. Line

330 Ft. from W. Line

WEST

EAST

SOUTH

1927

Date

REPORT

9/21	R.O.G.
9/28	Rig
10/5	Rigging up -
10/12	Rigged up - waiting for power
10/19	Spud - S.D.
10/26	—
11/2	—
11/9	—
11/16	—
11/22	Drilg 605-
11/29	" 813-
12/7	12 1/2" @ 955 - drilg 955-
12/14	Drilg 1050
12/21	" 1750
12/28	" 2320
1928	
1/4	T.D. 2360 S.D. having trouble between themselves
1/11	— 2/22 — 3/8 —
1/18	— 2/29 — 4/4 —
1/25	— 3/7 — 4/11 —
1/31	— 3/14 — (over.)
2/15	— 3/21 —

4/18 - Dwg 2660-50

4/25 - " 2950
3252

4/25 - " 2950
5/2 - " 3252 - Showail 3155-

5/2 — " 322
5/9 — Top Oswald sand 3265 —
drilling 3295

5/9 - Top Oswald Panel 3
drilling 3295 -
5/6 - Drilling 3480 -
3595

5/16 Drilling 3480 ⁰
3595

5/16 - Wren 3595
5/23 - " 3150

5/23 — " 3650
5/31 — " 3650

5/31 — " 3695'
6/6 — Top Granite W. 3695'
T.D. 3703 N. & A.

T.D. 3703 A. & A.

Osborne, Homer
 Map No. **KANSAS** Sec. *30* Twp. *9* R. *15W*

Well No. *1* *Pratter**Pratter, Davis & Kueger* Company

Contractor

SECTION PLAT

-----Ft. from N. Line

330-----Ft. from S. Line

-----Ft. from E. Line

330-----Ft. from W. Line

FIRST REPORTS

Location -----

Rig up -----

Drilling and Remarks:

RCY

RECORD

Cased-----in., -----ft.

Sand -----

Gas-----

Oil-----

Total Depth-----

PRODUCTION

1st 24 hrs. Nat.-----

1st 24 hrs. after shot-----

Gas-----Cu. Ft.

Dry Hole-----

Abandoned-----

Date

SEP 21 1927

S. J. LEWIS

Scout

Map No. KANSAS Sec. 30 Twp. 9 R. 15W

Well No. 1 Prather

Prather, Davis & Krueger Company

Contractor

SECTION PLAT

_____ Ft. from N. Line

330 Ft. from S. Line

_____ Ft. from E. Line

330 Ft. from W. Line

ABANDONED

		0	

Location _____

Rig up _____

Drilling and Remarks:

3695 Top Granite

Wash.

TJ 3703

D. & A.

RECORD

Cased _____ in., _____ ft.

Sand _____

Gas _____

Oil _____

Total Depth _____

PRODUCTION

1st 24 hrs. Nat. _____

1st 24 hrs. after shot _____

Gas _____ Cu. Ft.

Dry Hole _____

Abandoned _____

Date

JUN 6 1928 S. J. LEWIS Scout

MAP NO. _____ SEC. 30 TWP. 9S R. 15WWELL NO. 1. PorterM. K. Huger COMPANY_____
no wall map CONTRACTOR

SECTION PLAT

FT. FROM N. LINE_____
FT. FROM S. LINE_____
FT. FROM E. LINE_____
FT. FROM W. LINE

LOCATION _____

RIG UP _____

DRILLING AND REMARKS:

RECORD

CASED _____ IN. _____ FT.

SAND _____

GAS _____

OIL _____

TOTAL DEPTH 3707

PRODUCTION

1ST 24 HRS. NAT. _____

1ST 24 HRS. AFTER SHOT _____

GAS _____ CU. FT.

DRY HOLE ✓

ABANDONED _____

DATE

6/12 192 8 SCOUT