


DX 78-1 Rooks

Section 30 Township 9S Range 17W

Well No. #1 Workman

Company Osage O & G Drlg

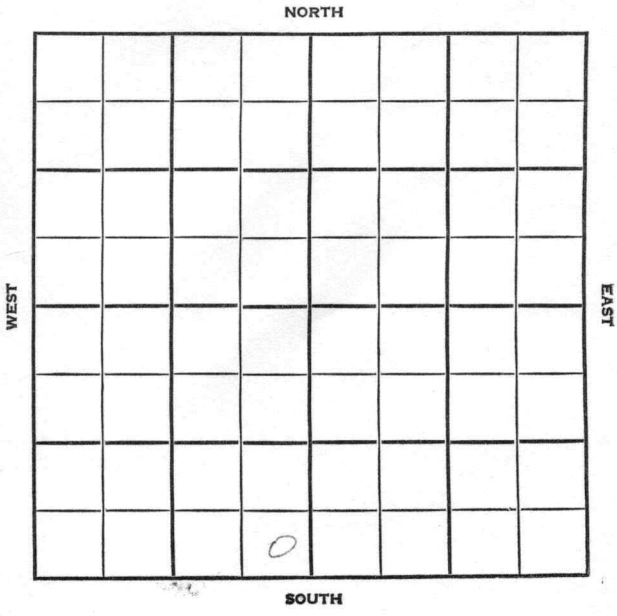

County Booke Elev. 2,113 DF
2,116 RB
 Sec. 30 Twp. 9S Rge. 17W
 Company Osare & C & G Drlg.
 Farm Name Workman No. 1

TOPS	DEPTH	LOG	DATUM	Loc. in Sec.
Anb.	1405			SE SE SW
TP.	3040			
H.	3255			
Tr.	3270			
Dg.				
Bl.				
L.	3294			Don Moore Geol.
K.C.				
B.K.C.	3522			Contr.
Ce.				C & G
C.	3536			
M.				Pool
M.				Ganoung
K.				
Mz.				
Ma.				
V.				
S.				
S.				
A.				ABANDONED
R.				
PE.				
G.				
TD.	3595			

Date Comm. AUG 29 1956
MIRT AUG 22 '56 SPD 8-17-56

8 5/8 184/160 Anby 1405 TP 3040
H 3255 Tr. 3270 DST 3262-78
we 1hr 310' OCMW BHP 930/30"
Lsg 3294 DST 3286-3305 we 90"
we 80' OCM BHP 660/30" # 3340
AUG 29 '56 X BKC 3522 c.g. 3536
RTD in c.g. 3595 Log #
D&A. R19 to 1st Rep.