

Section 30 Township 9 Range 18 W

Well No. # 1 Jelinek

Company Heathman & Strain Drlg.

NORTH

						0	

WEST

EAST

SOUTH

Sec. 30 Twp. 9 R. 18W

Well No. #1 Jelinek Farm

Heathman & Strain Drlg. Company

Strain Drlg. Contractor


Wildcat

330 Ft. from N. Line

_____ Ft. from S. Line

990 Ft. from E. Line

_____ Ft. from W. Line

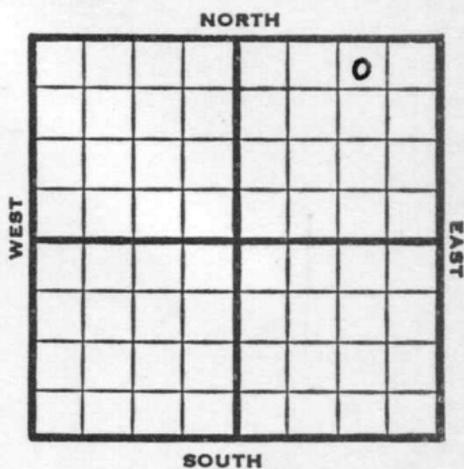

NW NE NE

1952 Elev. 2193' REPORT

11/26 Spud 11-24-52
8" @ 136' Drlg.

12/4 Drlg. 3000'

12/11 Heeb 3326 Tor 3348 KC 3367 Arb 3608
RTD 3614 5" @ 3610 MICT

12/18 DD 3617 TD 1 BOPH 7000A S/7 1/2 BOPH

12/25 DD 3617 TD 1 BOPH

12/30 Spud 11-24-52

Oil Well

TD 3617

8" @ 136

Heeb 3326, Tor. 3348, KC 3367

DST 3446-60, opn 1 1/4 hrs., rec.

90' socm, 120' hocm, 300' gassy

oil, 300' wtr & gco, 240' sw

990#

DST 3530-45, opn 1 hr., Rec.

1920' fluid, 10% oil, 1010#

B KC-3560, Arb. 3608, odor &

stain

DST 3606-14, opn 1 1/2 hrs., Rec.

130' clean oil, 90' muddy oil

740#

5" @ 3610, DD3617, 1 boph 7000A

OVER

#1 Jelinek
(Information Brought Forward)

1952

12/30

S/7 $\frac{1}{2}$ boph

Comp. 447 bopd

COMPLETED

