



Sec. 30 Twp. 9 R. 18W

Well No. #2 Jelinek Farm

Heathman & Co. Company

Strain Drlg. Contractor


Baumgarten Pool

330 Ft. from N. Line

\_\_\_\_\_ Ft. from S. Line

330 Ft. from E. Line

\_\_\_\_\_ Ft. from W. Line

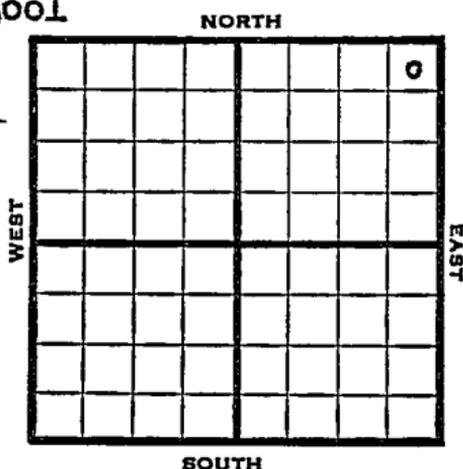

NE NE NE

1953 Elev. 2192' REPORT

5/6 M I R

5/21 No report

5/28 " "

6/10 Spud ~~505-53~~

Oil Well

TD 3655'

8" @ 155'

Heeb 3323, Tor 3344, Lans 3363

DST 3368-3410 opn 1/2 hr, rec 15' mud 540#

DST 3441-54 opn 1 hr, rec 125' hocm 150' wtr.

1000#

DST 3514-25 opn 1/2 hr, rec 6' mud 780#

DST 3555-71 opn 1/2 hr, rec 8' mud 480#

Arb 3604,

DST 3606-20 opn 1 hr, rec 270' oil 180' hocm 780#

DST 3620-40 opn 3/4 hr, rec 330' hocm 425' oil 770#

DST 3640-55 opn 1/2 hr, rec 1600' wtr. 1020#

TD 3655'

5" @ 3655'

CO to 3658

26/ 3646-55 FU 200' wtr. 3/4 hr.

OVER

1953

Information brought forward.

6/10

CO to 3645

17/ 3635-41 B/  $1\frac{1}{4}$  boph

12/ 3635-39 500 A S/ 158 bo  $1\frac{1}{4}$  bw  
9 hr.

Comp. 348 bopd.

**COMPLETED**





Dirig. Data

12/3635-39 500 A 8/15/58 bo 1 1/2 bw 9 hr

Comp. 348 bopd Pierce Map

France Map

Tracings

Land Wall Map

Land Small Map

Scout Cards

JUN 16 1958