

SOUTH

KANSAS

Rooks

Sec. 30 Twp. 9 R. 20W ✓

Well No. #1 Baldwin Farm

Nadel & Gussman Company

Wildcat


330' Ft. from N. Line

_____ Ft. from S. Line

_____ Ft. from E. Line

330' Ft. from W. Line

NW/c

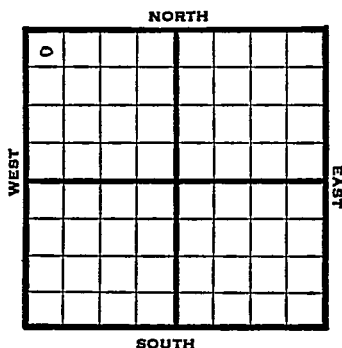

1948

Eli 2306'

R E P O R T

9/15 Location

9/21 Surface hole

9/29 8" @ 230-3200'

10/6 Arb. 3868'-72'

TD 3872'

5" @ 3869'

10/13 Shot 33 bbls oil 1 hr

10/20 TD 3872'

Arb. 3868'

5" @ 3869'

Echo Pot 1226 Oil

275 Gr.

Comp

COMPLETED

Rooks County Kansas State

Map No. _____ Sec. 30 Twp. 9 R. 20W

Well No. 1 Baldwin

Nadel & Gussman Company

FIRST REPORT Contractor

NW/C

SECTION PLAT

330 Ft. from N. Line

_____ Ft. from S. Line

_____ Ft. from E. Line

330 Ft. from W. Line

o									

Wildcat

Remarks:

Location

Date
SEP 15 1948

Signed
S. J. LEWIS

Kansas

Map No. 65 Sec. 30 Twp. 9 R. 20WWell No. 1 BaldwinNadel & Gussman

Company

COMPLETE

Contractor

NW/C

E12361**SECTION PLAT**330 Ft. from N. Line Ft. from S. Line Ft. from E. Line330 Ft. from W. Line

0			

Rooks CountyLocation Rig up

Drilling and Remarks:

Per # 38685' @ 386.9Echo Per # 1226 rd275 lb**RECORD**Cased in., ft.Sand Gas Oil Total Depth 272**PRODUCTION**1st 24 hrs. Nat. 1st 24 hrs. after shot Gas Cu. Ft. Dry Hole Abandoned

Date

OCT 20 194819S. J. LEWIS

Scout