

Section 30 Township 9 Range 21W

Well No. 1 Smith

Company Shield et al

Wildcat  
NORTH

							0
							.

WEST

EAST

SOUTH

**KANSAS**

Graham

Sec. 30 Twp. 9 R. 21W ✓

Well No. #1 Smith Farm

Shield et al Company

Wildcat


330' Ft. from N. Line

\_\_\_\_\_ Ft. from S. Line

330' Ft. from E. Line

\_\_\_\_\_ Ft. from W. Line

NE/C

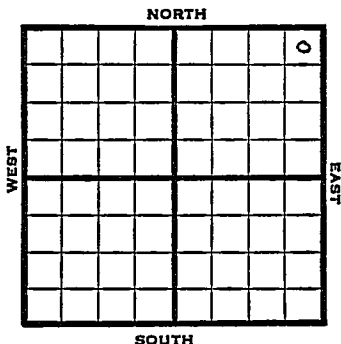

1948 Elev. 2326' REPORT

12/15 ROR  
12/22 8" @ 167'

12/29 Drlg 3115'  
4000 SD

1949  
1/5 Lans. 3579'  
Cong. 3911'  
TD 4000 in Cong.  
**ABANDONED**

Map No. \_\_\_\_\_ Sec. 30 Twp. 9 R. 21W

Well No. 1 Smith

Shield etal. \_\_\_\_\_ Company

FIRST REPORT \_\_\_\_\_ Contractor

NE/C

SECTION PLAT

330 Ft. from N. Line

\_\_\_\_\_ Ft. from S. Line

330 Ft. from E. Line

\_\_\_\_\_ Ft. from W. Line


Graham County

Location \_\_\_\_\_

Rig up \_\_\_\_\_

Drilling and Remarks:

R U R

RECORD

Cased \_\_\_\_\_ in., \_\_\_\_\_ ft.

Sand \_\_\_\_\_

Gas \_\_\_\_\_

Oil \_\_\_\_\_

Total Depth \_\_\_\_\_

PRODUCTION

1st 24 hrs. Nat. \_\_\_\_\_

1st 24 hrs. after shot \_\_\_\_\_

Gas \_\_\_\_\_ Cu. Ft.

Dry Hole \_\_\_\_\_

Abandoned \_\_\_\_\_

Date

DEC 15 1948

19

S. J. LEWIS

Scout

Kansas

Map No. 65 Sec. 30 Twp. 9 R. 21WWell No. 1 SmithShield etal. Company**ABANDONED**

Contractor


NE/C

E1, 2326  
SECTION PLAT330 Ft. from N. Line

\_\_\_\_\_ Ft. from S. Line

330 Ft. from E. Line

\_\_\_\_\_ Ft. from W. Line

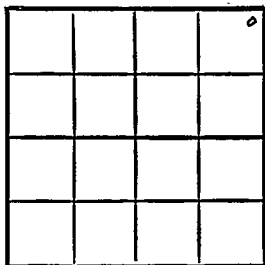

Graham County

Location \_\_\_\_\_

Rig up \_\_\_\_\_

Drilling and Remarks:

Line 3579  
Comp 8911**RECORD**

Cased \_\_\_\_\_ in., \_\_\_\_\_ ft.

Sand \_\_\_\_\_

Gas \_\_\_\_\_

Oil \_\_\_\_\_

Total Depth 4000 in Comp**PRODUCTION**

1st 24 hrs. Nat. \_\_\_\_\_

1st 24 hrs. after shot \_\_\_\_\_

Gas \_\_\_\_\_ Cu. Ft.

Dry Hole \_\_\_\_\_

Abandoned \_\_\_\_\_

Date

JAN 5 1949 19S. J. LEWIS

Scout