Graham

KANSAS


SECTION 30 TOWNSHIP 9S RANGE 21W

WELL NO. #1 Smith

COMPANY Cook & Galloway & Oil Trading

NORTH

NW NW NE

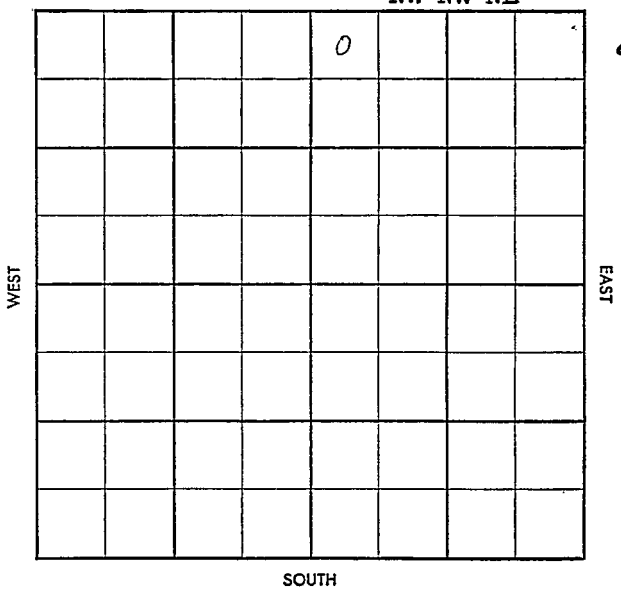

FORM 504-S SUNRAY

WILDCAT

S–513–B

County Graham Elev.

Sec. 30 Twp. 9 Rge. 21W

Company Cook & Galloway and Oil Trading

Farm Name Smith No. 1

TOPS	DEPTH	LOG	DATUM
Anh.			
Tp.			
H.			
Tr.			
Dg.			
B.L.			
L.			
K.C.			
B.K.C.			
Ce.			
C.			
M.			
M.			
K.			
Mz.			
Mq.			
V.			
S.			
S.			
A.			
R.			
Pf.			
G.			
T.D.			

Loc. in Sec. NW NW NE

Geol.

Contr. C & G #1

Pool Wildcat

APR 16 '58

FIRST REPORT

Date Comm.

Location

Co. Lse. No. Sec. T. R.

Twp. Pool

Co. Facet

S-513-B

County Graham Elev. 2341 DF 2347 KB

Sec. 30 Twp. 9 Rge. 21W

Company Cook & Galloway and Oil Trading

Farm Name Smith No. 1

TOPS	DEPTH	LOG	DATUM
Anh.	1956		
Tp.			
H.	3543		
Tf.	3567		
Dg.			
B.L.			
L.	3583		
K.C.			
B.K.C.	3801		
Ce.			
C.	3918		
M.			
M.			
K.			
Mz.			
Mq.			
V.			
S.			
S.			
A.			
R.			
Pf.			
G.			
T.D.	3944		

Loc. in Sec. NW NW NE

Geol.

Contr. C & G #1

Pool Wildcat

ABANDONED APR 30 '58

Date Comm. 4-16-58 8" 195 bbl

Location APR 23 '58 4 3593 APR 30 '58

DST 3733 - 45 op 30" 12' M

BHP 270/20 no log

D&A

Co. Lse. No. Sec. T. R.