

Section 30 Township 9 Range 21WWell No. 1 SmithCompany W. I. Hartman

NORTH

13

WEST

EAST

SOUTH

Graham

KANSAS

Sec. 30 Twp. 9 R. 21 W ✓Well No. # 1 Smith FarmW. L. Hartman CompanyHartman Contractor

Wildcat


Ft. from N. Line

330 Ft. from S. Line

Ft. from E. Line

330 Ft. from W. Line

SW SW SW

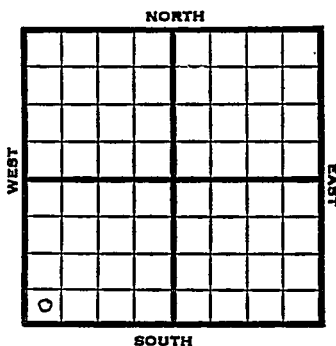

1951

Elev. 2339⁺ REPORT

8/1

Spud 7-27-51

8" @ 162

Drlg. 2242'

8/15

Spud 7-27-51

D & A TD 3961' 8" @ 162'

Top. 3317' Heeb 3532'

DST 3516-45 open 20 min. rec 600' SW

DST 3556-68 open 1 hr. rec 30' mud

Lans. 3570'

DST 3610-21 open 20 min. rec 392' SW


DST 3740-52 open $\frac{1}{2}$ hr. rec 4' mudDST 3758-75 open $\frac{1}{2}$ hr. rec 14' mud

B KC 3794' Marm. 3855' Cong 3878'

Rework Simp. 3909'

TD 3961' D & A

ABANDONED

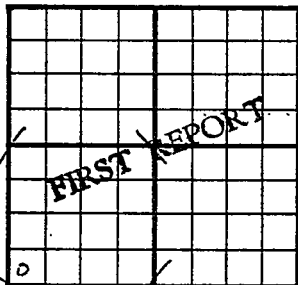County Graham State KansasSec. 30 (Blk.) 9 (Sur.) 21W Map No.Operator W. L. HartmanWell No. 1 Farm SmithElev. 2339 Location SW SWSW330 Ft. From S Line SW330 Ft. From W Line Quarter1st. Report AUG 1 1951

Completion

Remarks

Hartman - Contr.Spudding Date 7-27-51Drig. Data Wildcat8" @ 162 drlg. 2242


J. E. TYRA

County Graham State Kansas
 Sec. 30 (Blk. 9 (Sur. 21W Map No.

Operator W. L. Hartman

Well No. 1 Farm Smith

Elev. 2339 Location SW SW SW

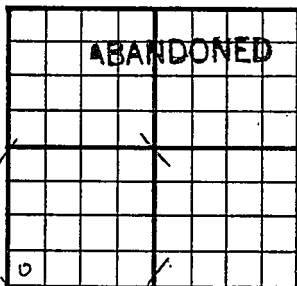

330 Ft. From S Line SW

330 Ft. From W Line Quarter

1st. Report

Completion AUG 15 1951

Remarks Wildcat

Hartman - Contr.

Spudding Date 7-27-51

Drig. Data D & A TD 3961

8" @ 162 Top. 3317 Heeb. 3532

DST 3516-45 open 20 min. Rec. 600' sw

DST 3556-68 open 1 hr. Rec. 30' mud

Lans. 3570 DST 3610-21 open 20 min.

Rec. 392' sw DST 3740-52 open $\frac{1}{2}$ hr.

Rec. 4' mud DST 3758-75 open $\frac{1}{2}$ hr.

Rec. 14' mud B KC 3794 Marm. 3855

Cong. 3878 Rework Simp. 3909 TD 3961

D & A

J. E. TYRA