

Give All Information Completely
Make Required Affidavit
Mail or Deliver Report to:
Conservation Division
State Corporation Commission
800 Bittling Building
Wichita, Kansas


WELL PLUGGING RECORD

OR

FORMATION PLUGGING RECORD

Strike out upper line
when reporting plug-
ging off formations.

NORTH

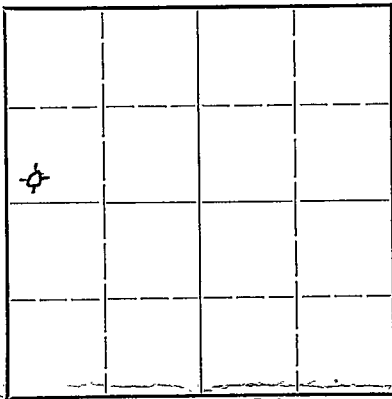

Locate well correctly on above
Section Plat

Graham County. Sec. 30 Twp. 23 Rge. (E) 26 (W)
Location as "NE $\frac{1}{4}$ NW $\frac{1}{4}$ SW $\frac{1}{4}$ " or footage from lines SW SW NW
Lease Owner White Eagle Oil Company
Lease Name Richmoier Well No. 1
Office Address 415 Philtown Bldg., Tulsa, Oklahoma
Character of Well (completed as Oil, Gas or Dry Hole) Dry Hole
Date well completed July 13 19 48
Application for plugging filed July 12 19 48
Application for plugging approved July 12 19 48
Plugging commenced July 12 19 48
Plugging completed July 13 19 48
Reason for abandonment of well or producing formation Dry Hole
If a producing well is abandoned, date of last production 19
Was permission obtained from the Conservation Division or its agents before plugging was com-
menced? Yes

Name of Conservation Agent who supervised plugging of this well Harl Dives
Producing formation Depth to top Bottom Total Depth of Well 1625 Feet
Show depth and thickness of all water, oil and gas formations.

OIL, GAS OR WATER RECORDS

CASING RECORD

Formation	Content	From	To	Size	Put In	Pulled Out
		<u>0</u>	<u>216'</u>	<u>8 5/8"</u>	<u>216'</u>	<u>None</u>

Describe in detail the manner in which the well was plugged, indicating where the mud fluid was placed and the method or methods used in introducing it into the hold. If cement or other plugs were used, state the character of same and depth placed, from feet to feet for each plug set.

From 1625' to 216' - Heavy Rotary Mud
216' to 214 1/2' - Wooden Plug
214 1/2' to 207' - 15 sacks cement by Halliburton
207' to 25' - Heavy Rotary Mud
25' to 23 1/2' - Wooden Plug
23 1/2' to 6' - 10 sacks cement by Halliburton
6' to surface - Gallor


(If additional description is necessary, use BACK of this sheet)

Correspondence regarding this well should be addressed to White Eagle Oil Company
Address 415 Philtown Bldg., Tulsa, Oklahoma

STATE OF Kansas, COUNTY OF Barton, ss.
Glenn W. Pool Oil Producer (employee of owner) or (owner or operator) of the above-described well,
being first duly sworn on oath, says: That I have knowledge of the facts, statements, and matters herein contained and the log of the above-
described well as filed and that the same are true and correct. So help me God.

(Signature)

Glenn W. Pool Oil Producer
By: Glenn W. Pool
P.O. Box 352, Holsington, Kansas
(Address)

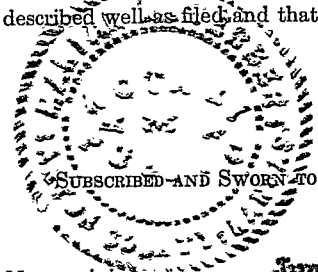

SUBSCRIBED AND SWORN to before me this 21st. day of July, 19 48.
My commission expires June 4, 1951

Marion M. Herbert
Notary Public.