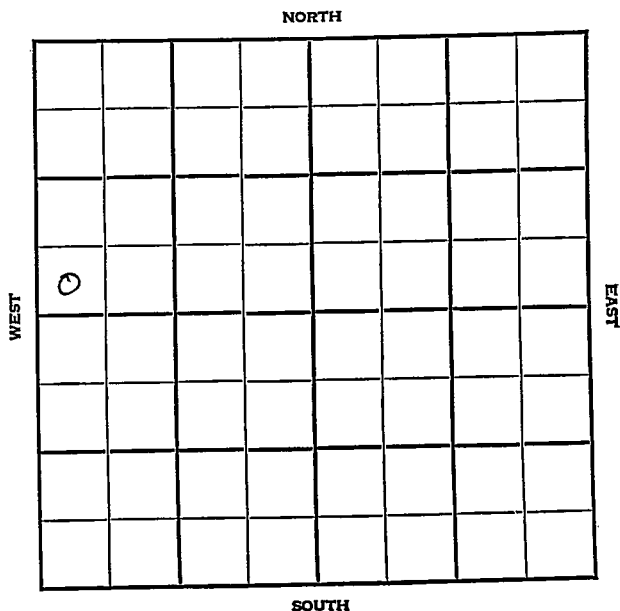


11/12/49
KANSASSection 30 Township 9 Range 25 WWell No. #1 RichmeierCompany Helmerich & Payne

maps show dry hole
TD 4625

LTR To TYCA 5-22-50
gt

KANSAS

Graham

Sec. 30 Twp. 9 R. 25-W

Well No. #1 Richmeier Farm

Helmerich & Payne Company

Contractor


Ft. from N. Line

330 Ft. from S. Line

Ft. from E. Line

330 Ft. from W. Line

SW NW

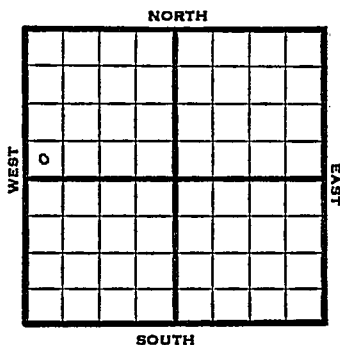

1948

Elev 2620

REPORT

7/14

8" @ 246
Heeb 3825
Lans 3875
VSSO 3973-78
Stain 4058-73
BKC 4129-4150
Miss Chert 4412
Miss lm 4462
Simp 4550
Arb 4575
TD 4625
Ran schlj
D&A

ABANDONED

Map No. _____ Sec. 30 Twp. 9 R. 25W

Well No. 1 Richmeier


Helmerich & Payne Company

FIRST REPORT

Contractor

SW NW

SECTION PLAT

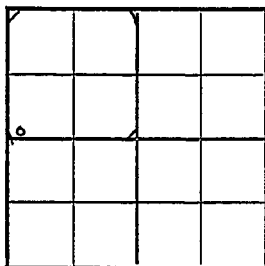

_____ Ft. from N. Line

330 Ft. from S. Line

_____ Ft. from E. Line

330 Ft. from W. Line

Graham County

Location _____

Rig up _____

Drilling and Remarks:

surface hole

RECORD

Cased _____ in., _____ ft.

Sand _____

Gas _____

Oil _____

Total Depth _____

PRODUCTION

1st 24 hrs. Nat. _____

1st 24 hrs. after shot _____

Gas _____ Cu. Ft.

Dry Hole _____

Abandoned _____

Date

JUN 23 1948 19 S. J. LEWIS Scout

Map No. _____ Sec. 30 Twp. 9 R. 25W

Well No. 1 Richmeier

~~Duplicate~~

Helmerich & Payne

Company

Contractor

SW NW

E1.2620
SECTION PLAT

_____ Ft. from N. Line

330 Ft. from S. Line

_____ Ft. from E. Line

330 Ft. from W. Line

Graham

Location _____

Rig up _____

Drilling and Remarks:

8" c 246

Neel. 3852

Lane. 3875

VSSO 3973-78

Stain 4068-73

BKC 4129-450

Missouri 4412

RECORD

Cased _____ in., _____ ft.

Sand _____

Gas _____

Oil _____

Total Depth _____

PRODUCTION

1st 24 hrs. Nat. _____

1st 24 hrs. after shot _____

Gas _____ Cu. Ft.

Dry Hole _____

Abandoned _____

Date

July 14 1948

J. E. TYRA Scout.

miss line
 D Simpson
 arb

T. D.

Ran Schlumberger

D + A 12 1950

4462	Misc.
4550	Pierce Map
4575	France Map
4635	Tracings
4647	Land Wall Map
	Land Small Map
	Scout Cards

















