


Section 30 Township 9S Range 25WWell No. #1 RichmeierCompany Helmerich & Payne Inc.

NORTH

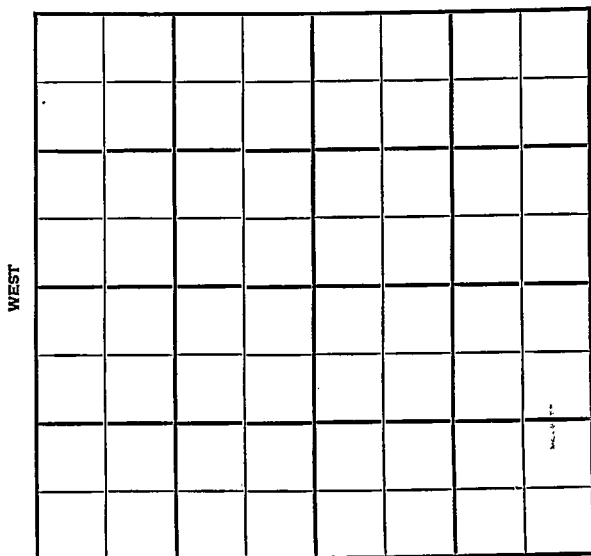

SOUTH

KANSAS

Graham

3510 of ✓

Sec. 30 Twp. 9 R. 25W

Well No. #1 Richmeier Farm

Helmerich & Payne Company

Wildcat


Ft. from N. Line

330' Ft. from S. Line

Ft. from E. Line

330' Ft. from W. Line

SW NW

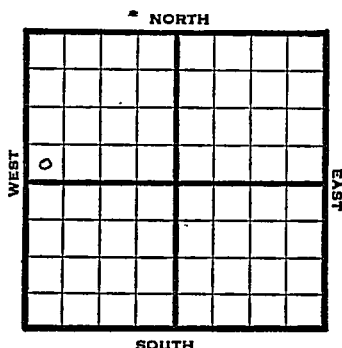

1948

Eli 2620'

REPORT

6/23	Surface Hole
6/27	Set 8-5/8" at 243' with 350 sacks. Drilling 1315' (Helmerich & Payne)
6/30	Drilling 2320' (Helmerich & Payne)
7/1	Drilling 2000' (Tel)
7/1	Drilling 2900' (Helmerich & Payne)
7/2	Drilling 3235' (Helmerich & Payne)
7/2	Drilling 3490' (Helmerich & Payne)
7/6	Drilling 3490' (Wire)
7/5	Drilling 3998' Top Heebner 3852' Kansas City 3875' Spotted staining 3973'-78' (Helmerich & Payne)
7/7	Staining heavy black oil 4068'-73' Drilling 4084' (Wire)
7/7	Drilling 4150' Base Kansas City 4129'. (Helmerich & Payne)
7/9	Drilling 4427' Top Miss. Chert 4415' (Helmerich & Payne)
7/11	Top Arbuckle 4575' TD. 4626' Want to plug well. Sinclair has Given their permission (Helmerich & Payne).

OVER

1948

7/14

TD 4625'

Miss 4462'

Simp 4550'

Arb. 4575'

Aband.

ABANDONED

Map No. 67 Sec. 30 Twp. 9 R. 25W

Well No. 1 Richmeier

Helmerich & Payne Company

ABANDONED

Contractor

SW NW

E 1,2620

SECTION PLAT

0			

 Ft. from N. Line

330 Ft. from S. Line

 Ft. from E. Line

330 Ft. from W. Line

Graham County

Location

Rig up

Drilling and Remarks:

Miss 4462.

Swing 4550

CR 4575

RECORD

Cased in., ft.

Sand

Gas

Oil

Total Depth 4625

PRODUCTION

1st 24 hrs. Nat.

1st 24 hrs. after shot

Gas Cu. Ft.

Dry Hole

Abandoned

Date

JUL 14 1948

19

S. J. LEWIS

Scout