


KANSAS

Section 30 Township 9 Range 32W

Well No. #1 Herbel

Company Westgate-Greenland

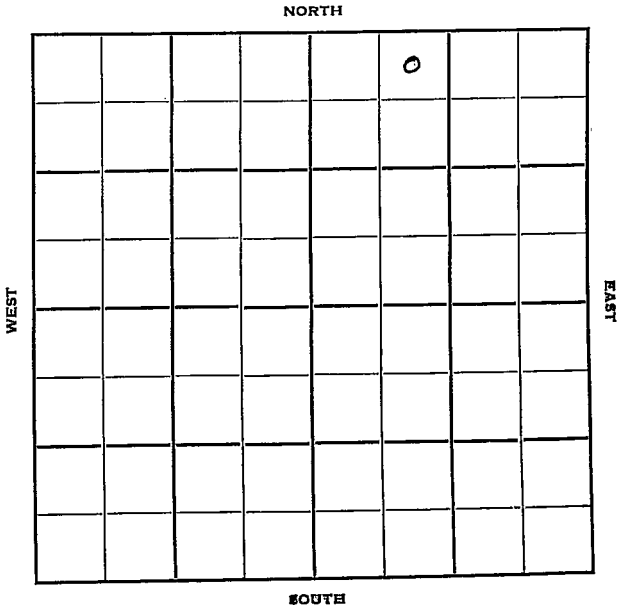

Sec. 30 Twp. 9 R. 32W

Well No. #1 Herbel Farm

Westgate-Greenland Company

Jackson Drlg. Contractor

Wildcat


330' Ft. from N. Line

_____ Ft. from S. Line

_____ Ft. from E. Line

990' Ft. from W. Line

NE NW NE

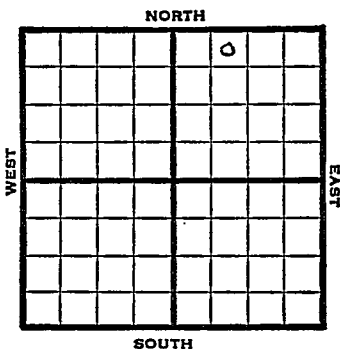

1950

Elev. 3103' REPORT

9/27
11/1

Location

D&A TD 5064'

Anhy 2638' Top 3738' Dodge 4053'

Lans. 4069' BKC 4414' Ft. Scott 4468

DST 4471-98 opn 1 hr Rec. 35' O&GCM

Miss 4676' Viola 4913'

Reworked Arb. 5008'

Arb. 5014'

TD 5064' 5" @ 4559'

60/4472-85 SSO 1000 A No inc.

5000A no inc. D&A

ABANDONED

