FORM 51


Rooks

KANSAS

Section 31 Township 9 Range 17W

Well No. 1 Adams

Company W.L. Hartman

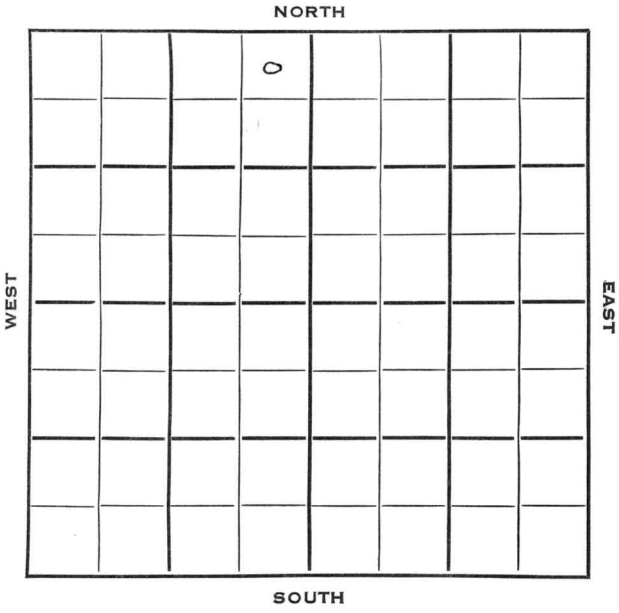

FORM 252-B

V

Rooks KANSAS

Sec. 31 Twp. 9 R. 17W

Well No. 1 Adams Farm

W. L. Hartman Company

Contractor

Wildcat


330 Ft. from N. Line

Ft. from S. Line

330 Ft. from E. Line

Ft. from W. Line

NE NE NW

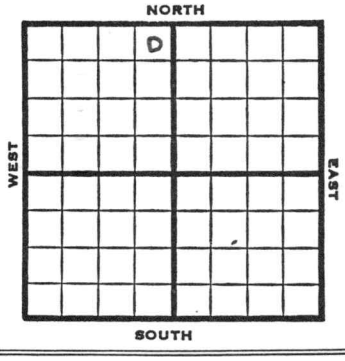

1953	Elev. 2103' REPORT
4/1	Spud 3-30-53
4/9	8" @ 124' Top. 3025 Drlg 3197'
4/16	5" Set
4/23	NR
4/30	"
5/6	DD 3590' TD 24/3548-56 24/3549-57 3000 A S/1 BFPH
5/21	Testing
5/28	"
6/3	"
6/10	Spud 3-30-53 Oil Well TD 3590' 8" @ 124' Top 3025, Heeb 3243, Tor 3260 DST 3180-97 opn 1 hr, rec 135' mud & wtr. DST 3206-17 opn 1 hr, rec 75' mud 1080# Lans 3281 DST 3274-91 opn 1 hr, rec 310' gas, 110' o & gcm 1020# DST 3319-33 opn 1 hr, rec 30' mud 960# DST 3365-77 opn 1 hr, rec 260' sw

OVER

1953

Information brought forward.

6/10 830#
DST 3418-32 opn 1 hr, rec 30' hocm
460#
DST 3433-48 opn 1 hr, rec 20' mud,
740#
DST 3448-67 opn 1 hr, rec 30' mud
0#
B KC 3511, Cong 3526,
DST 3508-39 opn 1 hr, rec 10' mud
Simp dol. 3550,
DST 3539-51 opn 1 hr, rec 10' mud 0#
DST 3551-57 opn 1 hr, rec 8' mud,
Arb 3573
TD 3575
5" @ 3574'
DD 3590 24/ 3548-56 24/ 3549-57
3000 A S/ 1 bfph 15 go PB 3456
30/ 3416-21 27/ 3426-30 1000 A
S/ 2½ boph 10 hr. SP 3360 54/ 3282-9
1 S/ 3½ boph 8 hr.
Comp. 214 bopd.

COMPLETED

FORM 275 FOR SALE BY KANSAS BLUE PRINT CO.


County Rooks State Kansas

Sec. 31 (Blk. Twp.) 9 (Sur. Rge.) 17W Map No.

Operator W. L. Hartman

Well No. 1 Farm Adams

Elev. Location NE NE NW

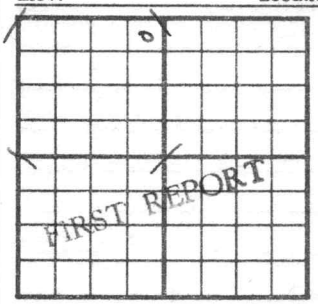

330 Ft. From N Line NW

330 Ft. From E Line Quarter

1st. Report APR 1 1953

Completion

Remarks

Spudding Date 3-30-53

Drlg. Data Wildcat

J. G. McGEHEE

FORM 275 FOR SALE BY KANSAS BLUE PRINT CO.


County Rooks State Kansas

Sec. 31 (Blk. Twp.) 9 (Sur. Rge.) 17W Map No.

Operator W. L. Hartman

Well No. 1 Farm Adams

Elev. 2103 Location NE NE NW

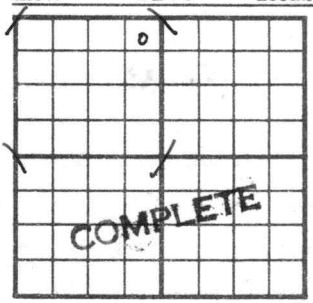

330 Ft. From N Line NW

330 Ft. From E Line Quarter

1st. Report

Completion JUN 10 1953

Remarks Wildcat

Spudding Date 3-30-53

Drlg. Data Oil well TD 3590

8" @ 124 Top. 3025 Heeb. 3243

Tor. 3260 DST 3180-97 open 1 hr.

Rec. 135' mud & wtr. DST 3206-17

open 1 hr. Rec. 75' mud 1080 #

Lans. 3281 DST 3274-91 open 1 hr.

Rec. 310' gas 110' o & gcm 1020#

DST 3319-33 open 1 hr. Rec. 30' mud

960# DST 3365-77 open 1 hr. Rec.

260' sw 830# DST 3418-32 open 1 hr.

Rec. 30' hocm 460# DST 3433-48 open 1 h

Rec. 20' mud 740# DST 3448-67 open 1 hr

Rec. 30' mud 0# B KC 3511 Cong. 3526

DST 3508-39 open 1 hr. Rec. 10' mud

Simp. dol. 3550 DST 3539-51 open 1 hr.

J. G. McGEHEE

Drlg. Data

Rec. 10' mud 0# DST 3551-57 open 1 hr.

Rec. 8' mud Arb. 3573 TD 3575 5" @

3574 ~~DD 3590~~ 24/ 3548-56 24/ 3549-57

3000 A S/ [illegible] PB 3456

30/ 3416-21 27/ 3428-30 1000 A S/ 2½

boph 10 [illegible] 54/ 3282-91

S/ 3½ boph 8 hr. Comp. 214 bopd

JUN 16 1958