

KANSAS

Rooks

Section 31 Township 9 Range 17-WWell No. #1 WesthusinCompany W L Hartman
Wildcat

NORTH

WEST

EAST

④							


SOUTH

Sec. 31 Twp. 9 R. 17WWell No. #1 Westhusin FarmW. L. Hartman Company

Wildcat

 Ft. from N. Line330' Ft. from S. Line Ft. from E. Line330' Ft. from W. Line

SW/C

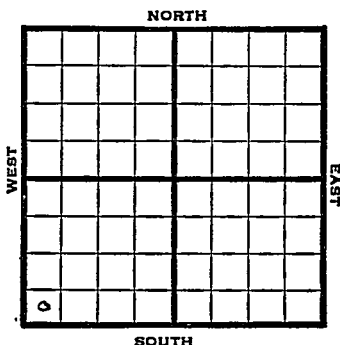

1948

Elev. 2118' REPORT

5/26	RUR
6/1	8" @ 200' Dr lg. 2692'
6/9	Topeka 3045' Lansing 3304' Simpson 3581 Arbuckle 3595' TD 3598' 5"@ 3595'
6/16	" "
6/23	" "
6/29	" "
7/8	TD 3615' EB 3516½ 24 shots 3477-88' 100' wtr. 245' heavy Oil
7/14	Rework Arb. 3613' 2500 acid 550' Oil 5140 Oil
7/21	255' oil 35' Wtr.
7/28	Pump 125 bbls oil 24 hrs.
8/4	"
8/11	"
8/18	"
8/25	"
9/1	"

OVER

1948

9/8 Pump 125 bbls oil 24 hrs.

9/14 "

9/21 "

9/29 "

10/6 "

10/13 "

10/19 "

10/26 "

11/3 "

11/10 "

11/16 "

11/23 "

11/30 "

12/8 "

12/15 TD 2615'

Lans 3304'

Ru Arb 3613'

Perf Lans 2500 acid

Pump 12 oil Pot

300° G_r.

Comp

COMPLETED

Map No. _____ Sec. 31 Twp. 9 R. 17W

Well No. 1 Westhusin

W. L. Hartman Company

FIRST REPORT

Contractor

SW/C


SECTION PLAT

Ft. from N. Line

330 Ft. from S. Line

Ft. from E. Line

330 Ft. from W. Line

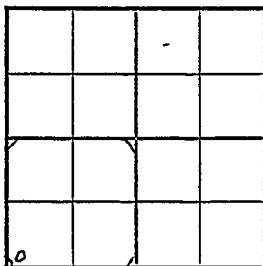

Rooks County

Location _____

Rig up _____

Drilling and Remarks:

R U R

RECORD

Cased _____ in., _____ ft.

Sand _____

Gas _____

Oil _____

Total Depth _____

PRODUCTION

1st 24 hrs. Nat. _____

1st 24 hrs. after shot _____

Gas _____ Cu. Ft.

Dry Hole _____

Abandoned _____

Date

MAY 26 1948 19 S. J. LEWIS Scout

Map No. 64 Sec. 31 Twp. 9 R. 17W

Well No. 1 Westhusin

W. L. Hartman Company

COMPLETE

Contractor

SW/C

E12118

SECTION PLAT

 Ft. from N. Line

330 Ft. from S. Line

 Ft. from E. Line

330 Ft. from W. Line

Rooks County

Location

Rig up

Drilling and Remarks:

Lease 3804
Re Co 43613
Perf Lease
2500 acs
Prod 12 oil 28
30 c/b

RECORD

Cased in., ft.

Sand

Gas

Oil

Total Depth 3615

PRODUCTION

1st 24 hrs. Nat.

1st 24 hrs. after shot

Gas Cu. Ft.

Dry Hole

Abandoned

Date

DEC 15 1948 19 S. J. LEWIS Scout