


Section 31 Township 9 Range 17W

Well No. #2 Westushen

Company W. L. Hartman

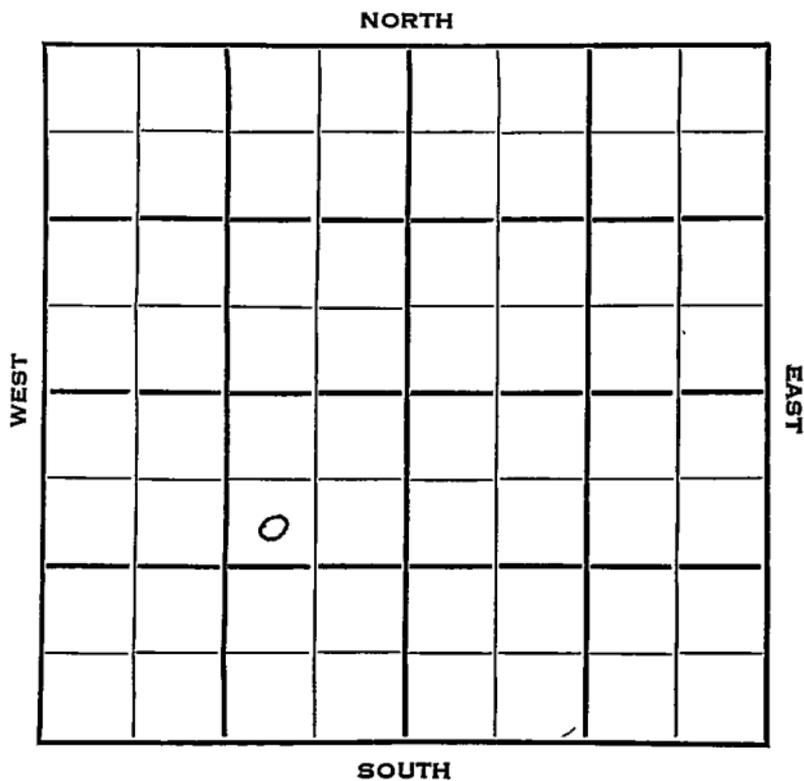



Sec. 31 Twp. 9 R. 17W

Well No. #2 Westushen Farm

W.L. Hartman Company

H & H Drlg. Contractor


Plainville Pool

990 Ft. from N. Line

_____ Ft. from S. Line

990 Ft. from E. Line

_____ Ft. from W. Line

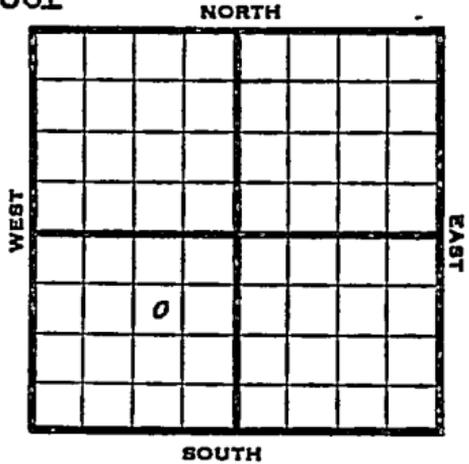

SW NE SW

1953

Elev. 2117' REPORT

8/19 Spud 8-17-53
8" @ 173'
WOC.

8/26 Top 3056, Heeb 3272, Tor 3289, KC 3310

9/2 Spud 8-17-53
D&A
TD 3670
8" @ 173
Top 3056, Heeb 3272, Tor 3289, KC
~~3310~~
DST 3237-59, opn 1 hr., rec. 150' wtr,
DST 3281-99, opn 40 mins., rec. 15'
mud, 400#
DST 3301-19, opn 40", rec. 15' mud,
60#
DST 3440-57, opn 40", rec. 15' mud,
160#
DST 3509-47, opn 40", rec. 12' mud,
155#
B KC 3550, Cong 3565, Simp 3624,
Simp. dol. 3635, Arb. 3655
TD 3670
D&A

ABANDONED

