
FORM 51 25M 8-50 WESTERN

Rooks KANSAS

Section 31 Township 9 Range 18W

Well No. #1 Baumgartner

Company Barnett Drlg.

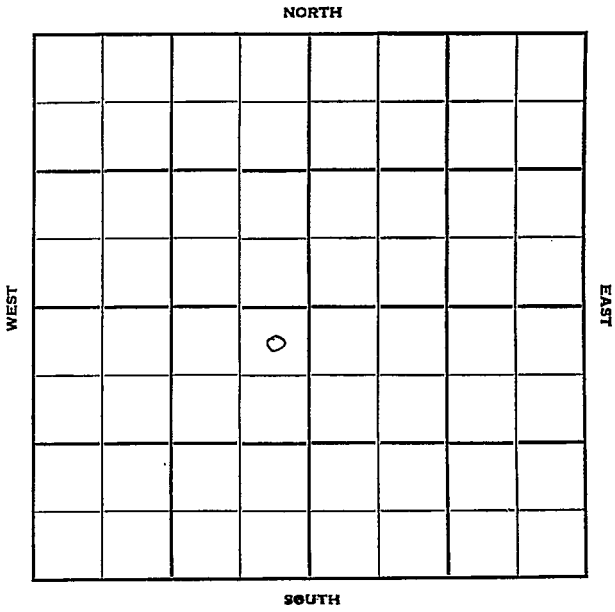

FORM 252-B
10M 11-50 PETROL

Rooks KANSAS

Sec. 31 Twp. 9 R. 18W

Well No. #1 Baumgartner Farm

Barnett Drlg. Company

Barnett Drlg. - Contr. Contractor

Wildcat


330' Ft. from N. Line

Ft. from S. Line

330' Ft. from E. Line

Ft. from W. Line

NE NE SW

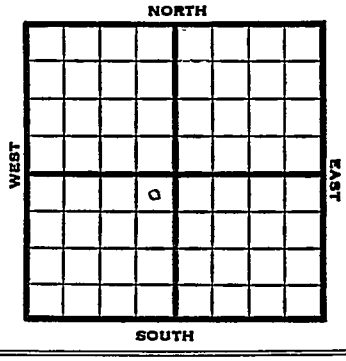

1950	Elev. 2192' REPORT
12/20	Spud 12-18-50 8" @ 157'
1951 1/3	Spud 12-18-50 D&A TD 3760 8" @ 157' Heeb. 3361' Lans. 3394 Arb. 3741-60 DST 3395-3408 opn ½ hr Rec. 15' mud DST 3310-36 opn 25 min Rec. 15' mud DST 3559-84 Rec. 135' mud TD 3760' D&A **ABANDONED**

FORM 275 FOR SALE BY KANSAS BLUE PRINT CO.


County Rooks State Kansas

Sec. 31 (Blk. Twp.) 9 (Sur. Rge.) 18W Map No.

Operator Barnett Drlg.

Well No. 1 Farm Baumgartner

Elev. Location NE NE SW

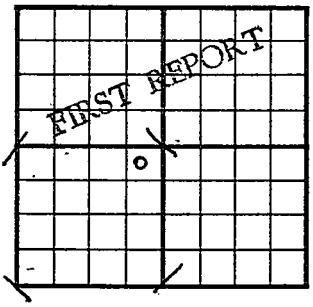

330 Ft. From N Line SW

330 Ft. From E Line Quarter

1st. Report DEC 20, 1950

Completion

Remarks Sinclair DHM

Barnett Drlg. - Contr.

Spudding Date 12-18-50

Drlg. Data Wildcat

8" @ 157

J. E. TYRA

FORM 275 FOR SALE BY KANSAS BLUE PRINT CO.


County Rooks State Kansas

Sec. 31 (Blk. Twp.) 9 (Sur. Rge.) 18W Map No.

Operator Barnett Drlg.

Well No. 1 Farm Baumgartner

Elev. 2192 Location NE NE SW

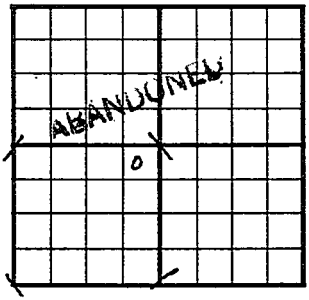

330 Ft. From N Line SW

330 Ft. From E Line Quarter

1st. Report

Completion JAN 3 1951

Remarks Wildcat

Barnett Drlg. - Contr.

Spudding Date 12-18-50

Drlg. Data D & A TD 3760

8" @ 157 Heeb. 3361 Lans. 3394

Arb. 3741-60 DST 3395-3408 open ½ hr.

Rec. 15' mud DST 3310-36 open 25 min.

Rec. 15' mud DST 3559-84 Rec. 135' mud

TD 3760 D & A

J. E. TYRA