


Section 31 Township 9 Range 19W

Well No. 1 - Casey

Company Francis Oil & Gas

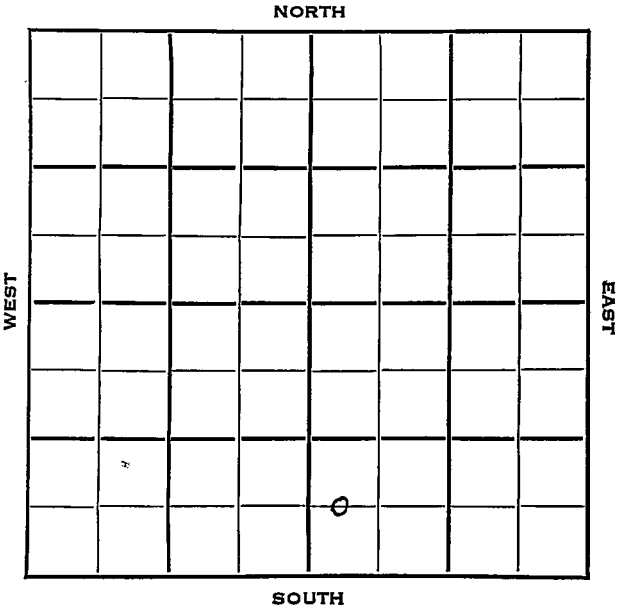

Rooks

KANSAS


 Sec. 31 Twp. 9 R. 19 W

 Well No. # 1 Casey Farm

Francis Oil & Gas Company

Marcotte Pool Contractor


 Ft. from N. Line

660 Ft. from S. Line

 Ft. from E. Line

330 Ft. from W. Line

C W L SW SE

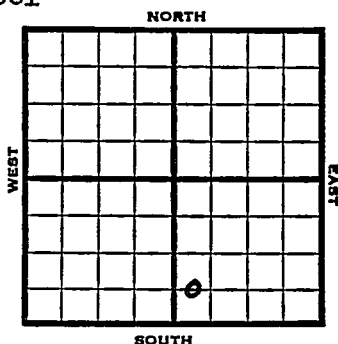

1952

Elev. 2225'

REPORT

12/30

Location

1/1

Location

1/8

8" @ 252 Anhy 1625 Drlg. 1775

1/15

 Heeb 3440, Dodge 3460, Lans
 3480
 Drlg. 3801'

1/22

NR

1/28

Spud 1-2-53

D&A

TD 3835

8" @ 252

 Anhy 1625, Heeb 3440, Dodge
 3460, Lans 3480, Cong 3732

TD 3835

D&A

ABANDONED

County **Rooks** State **Kansas**

Sec. **31** (Blk. **9** (Sur. **19W** Map No.

Operator Francis Oil & Gas

Well No. **1** Farm **Casey**

Elev.	2225	Location	C W L SW SE
-------	------	----------	-------------

FIRST REPORT

660 Ft. From S Line SE

330 Ft. From ~~TS~~ Line Quarter

1st. Report DEC 30 1952

Completion


Remarks

Spudding Date

Drwg. Data	Marcotte Pool
Location	

J. G. McGEHEE

County Rocks State Kansas
 Sec. 31 (Blk.) 9 (Sur.) 19W Map No.
 Operator Francis Oil & Gas
 Well No. 1 Farm Casey
 Elev. 2225 Location C W L SW SE

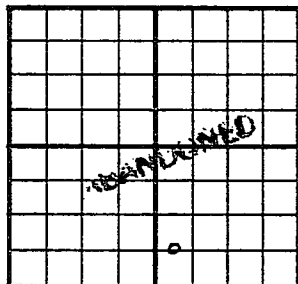

660 Ft. From S Line SE
330 Ft. From W Line Quarter

1st. Report

Completion JAN 28 1953

Remarks Marcotte Pool

Spudding Date 1-2-53

Drlg. Data D & A TD 383 5
8" @ 252 Anhy 1625 Heeb. 3440
Dodge 3460 Lans. 3480 Cong. 3732
TD 3835

D & A

J. G. McGEHEE