

Section 31 Township 9 Range 20WWell No. #1 Renner "A"Company Bennett & Roberts

NORTH

WEST

EAST

							0

SOUTH

Rooks

KANSAS

Sec. 31 Twp. 9 R. 20W

Well No. #1 Renner "A" Farm

Bennett & Roberts Company

Bennett & Roberts Contractor

Palco Pool


Ft. from N. Line

330 Ft. from S. Line

330 Ft. from E. Line

Ft. from W. Line

SE SE SE

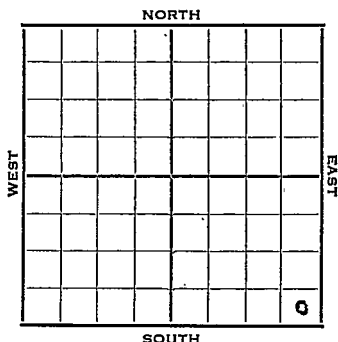

1953

Elev. 2253' REPORT

7/14

Spud 7-11-53
8" @ 187 w/150
Anh 1775
Drlg. 2390'

7/22

Heeb 3510 Lans 3552 B KC 3778
Cong 3846
Drlg. 3873

7/29

Spud 7-11-53 D & A TD 3898
8" @ 187 Anhy 1775' Heeb 3510'
Lans 3552' B KC 3778 Cong 3846
TD 3898 D & A

ABANDONED


J. G. McGEHEE

County _____ Rocks _____ State Kansas
 Sec. 31 (Blk. 9) (Sur. 20W) Map No. _____
 (Twp.) (Rge.)

Operator Bennett & Roberts

Well No. 1 Farm Renner "A"

Elev. 2253 Location SE SE SE

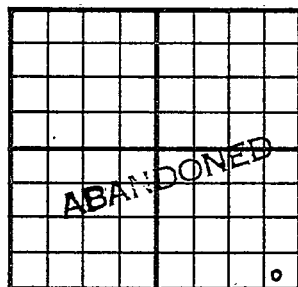

330 Ft. From S Line SE

330 Ft. From E Line Quarter

1st. Report

Completion JUL 29 1953

Remarks Palco Pool

B & R - Contr.

Spudding Date 7-11-53

Drig. Data D & A TD 3898

8" @ 187 Anhy 1775 Heeb. 3510

Lans. 3552 B KC 3778 Cong. 3846

TD 3898

D & A

J. G. McGEHEE