

Section 31 Township 9 Range 21WWell No. #1 EichmanCompany Heathman & Company

NORTH

				0			

SOUTH

WEST

EAST

2

Graham

KANSAS ✓

Sec. 31 Twp. 9 R. 21WWell No. #1 Eichman FarmHeathman & Co.

Company

Virginia Drlg.

Contractor

Wildcat330

Ft. from N. Line


Ft. from S. Line

Ft. from E. Line

330

Ft. from W. Line

NW NW NE

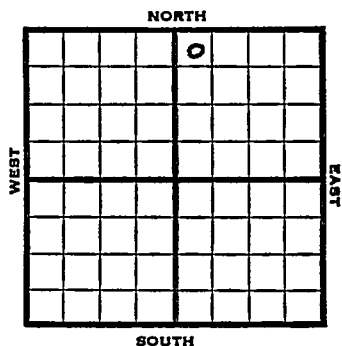

1953

Elev. 2333 : REPORT

3/25

Spud 3-22-53
8" @ 180'

4/2

Top 3325 - Heeb 3537 Dodge 3557
Lans. 3576'
Drlg. 3790

4/8

Spud 3-22-53
TD 3969'
8" @ 180
Top 3325, Heeb 3537, Dodge 3557, Lans
3576, B KG 3803, Cong 3942,
TD 3969'
D & A**ABANDONED**

County Graham State Kansas
 Sec. 31 (Blk.) 9 (Sur.) 21W Map No. _____
 Operator Heathman & Co.
 Well No. 1 Farm Eichman
 Elev. _____ Location NW NW NE

330 Ft. From N Line NE330 Ft. From W Line Quarter1st. Report MAR 25 1953


Completion _____

Remarks _____

Virginia Drlg. - Contr.Spudding Date 3-22-53

Drlg. Data _____

Wildcat8" @ 180

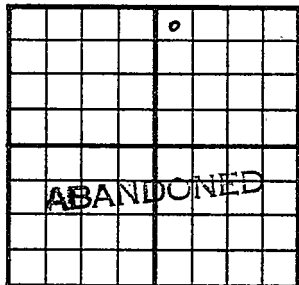County Graham State KansasSec. 31 (Blk.
Twps.) 9 (Sur.
Rge.) 21W Map No.Operator Heathman & Co.Well No. 1 Farm EichmanElev. 2333 Location NW NW NE330 Ft. From N Line NE330 Ft. From W Line Quarter1st. ReportCompletion APR 8 1953Remarks WildcatVirginia Drlg. - Contr.Spudding Date 3-22-53Drlg. Data D & A TD 39698" @ 180 Top. 3325 Heeb. 3537Dodge 3557 Lans. 3576 B KC 3803Cong. 3942 TD 3969D & A

J. G. McGEHEE