


DX 78-1

Graham

KANSAS

Section 31 Township 9 Range 21W
Well No. #1 Ichman "A"
Company Petroleum Inc.

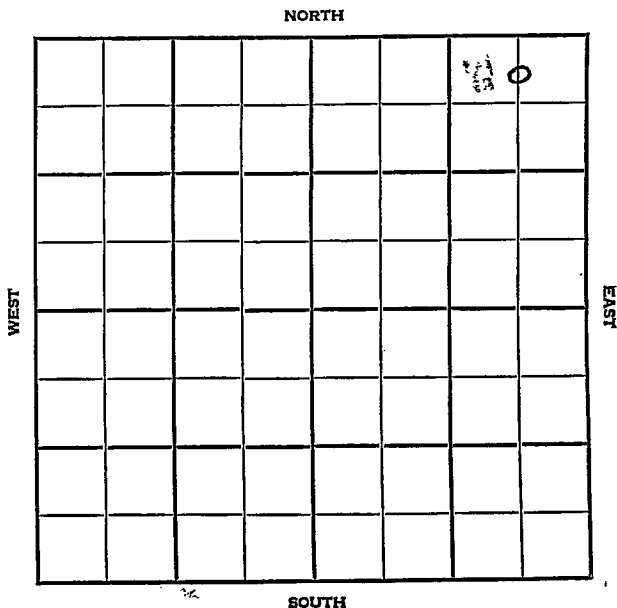

Grham KANSAS

SEC.	TWP.	R.
31	9	21W

WELL NO.

1 Ichman "A"

FARM

COMPANY

Petroleum, Inc.

CONTRACTOR

Garvey


330 Ft. from N. Line

Ft. from S. Line

660 Ft. from E. Line

Ft. from W. Line


C N/2 NE NE

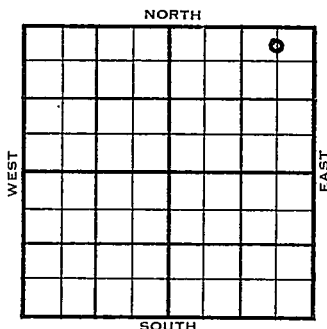

	ELEVATION	REPORT
1954	2322'	

11/3 MIM
 11/23 Spud 11-2-54
 D & A
 TD 3965'
 8-5/8" @ 211'
 Anhy 1794', Heeb 3528' Tor 3552'
 Lans 3569' Cong 3922'
 TD 3965'
 D & A

ABANDONED

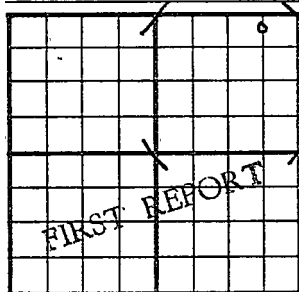County Graham State KansasSec. 31 (Blk. Twp.) 9 (Sur. Rge.) 21W Map No.Operator Petroleum Inc.Well No. 1 Farm Ichman "A"Elev. Location C N $\frac{1}{2}$ NE NE330 Ft. From N Line NE660 Ft. From E Line Quarter1st. Report NOV 3 1954

Completion

Remarks


Garvey - Contr.

Spudding Date

Drilg. Data

M I M

FABEN GILSTRAP

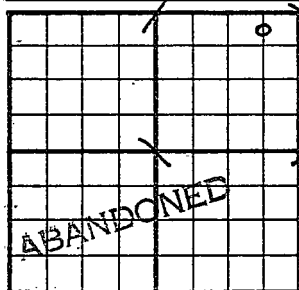County Graham State KansasSec. 31 (Blk.) 9 (Sur.) 21W Map No.Operator Petroleum Inc.Well No. 1 Farm Iohman "A"Elev. 2322 Location C N $\frac{1}{2}$ NE NE330 Ft. From N Line NE660 Ft. From E Line Quarter

1st. Report

Completion NOV 23 1954

Remarks

Garvey - Contr.Spudding Date 11-2-54Drig. Data D & A TD 39658 5/8" @ 211 Anhy 1794 Heeb. 3528Tor. 3552 Lans. 3569 Cong. 3922 TD 3965D & A

FABEN GILSTRAP