

Graham

KANSAS

SECTION 31 TOWNSHIP 9S RANGE 22W

WELL NO. #2 Sutor "E"

COMPANY Petroleum Inc.

NORTH E/2 NW SW

WEST

EAST

SOUTH

12

0

SEC. 31	TWP. 9 S	R. 22 W
------------	-------------	------------

WELL NO.

2 Sutor "E"

FARM

COMPANY

Petroleum Inc.

CONTRACTOR

Garvey Tools

Vesper


_____ FT. FROM N. LINE

_____ FT. FROM S. LINE

_____ FT. FROM E. LINE

_____ FT. FROM W. LINE

E/2 NW SW

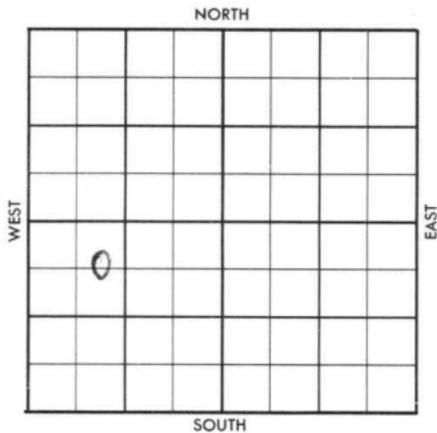

SDX-1/2 Mile

	ELEVATION	REPORT
1957	2383' RB	
10/2	Spud 9-25-57 8" @ 247 w/200 Drlg. 3750' Tops: Anhy 1940', Top 3392', Heeb 3613 Tr. 3635', Lans. 3649' (FR Tkt)	

Red Line
1001 4 100
M.M

~~S~~

S-513-A

FIRST REPORT
1/2 MILE
OCT 2 1957

CO. ~~Graham~~ ELEV 2383RB
SEC. 31 TWP. 9 RGE. 22W
COMPANY Petroleum Inc. NO. 2
SDX

FARM Sutor "E"
LOC. E/2 NW SW

Tops	
Anhy	1940
Top	3392
Heeb	3613
Tr.	3635
Lans	3649

GEOL.
CONTR. Garvey Tools
POOL Vesper
SPUD 9-25-57
8" @ 247 w/200, Drlg.
3750

CO.
LSE.
NO.
SEC.
TWP.
RGE.

~~Redline~~

S-513.A

CO Graham ELEV 2383 RE COMPLETE
TWP. 9 RGE. 22W
COMPANY Petroleum Inc. NO. 2

COMPLETE

1/2 MILE

DEC 4 '57

FARM Sutor "E"

LOC. E/2 NW SW

Tops	
Anhy	1940
Top	3392
Heeb	3613
Tr.	3635
Lans	3649
BKL	3877
TD 3925	

GEOL. _____
 CONTR. Garvey Tools
 POOL Vesper
 SPUD 9-25-57
 8" @ 247 w/200, Drlg.
 3750 OCT 9 '57 DST
 3650 - 3745 1hr
 470' wtng M BHP
 1100/20" DST 3763-95
 1hr 30' M BHP 200/20"

DST 3805-15 60" G/45"
 2160' free oil BHP 1120/20"
 DST 3820-35 60" G/17" 3505'
 free oil BHP 1190/20" DST
 3844-3925 30" 35' M BHP 300/20"
 4" 3922/157 WOCT OCT 19 '57
 CO 3899 1/2 24/ 3824-30
 16/ 3812-16 \$ 2250 PH NW
 4 hrs 5' Ld 3100' OB
 OCT 23 '57 816 BHP 16 PH 1hr W

3100' OB NT POP OCT 30 '57
 NOV 6 '57 NOV 13 '57 NOV 20 '57 NOV 27 '57 DEC 4 '57

PHY P 90 B 2 pd NW
 410.92

Lsg 3812-30

CO.
LSE.
NO.
SEC.
TWP.
RGE.