


Section 32 Township 9 Range 19W

Well No. #4 Lynd

Company Jones, Shelburne & Farmer

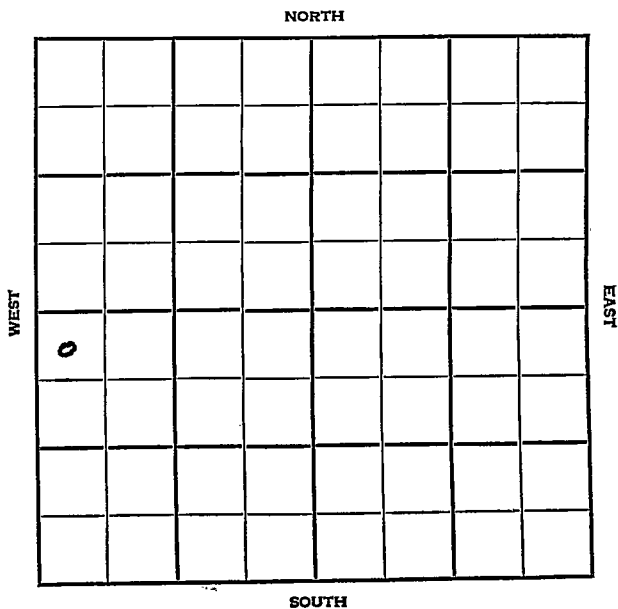

Rooks KANSAS

SEC. 32	TWP. 9	R. 19W
------------	-----------	-----------

WELL NO. 4 Lynd FARM

COMPANY Jones, Shelburne & Farmer


CONTRACTOR Co. Tools
Lynd Pool

330 Ft. from N. Line

Ft. from S. Line

Ft. from E. Line

330 Ft. from W. Line

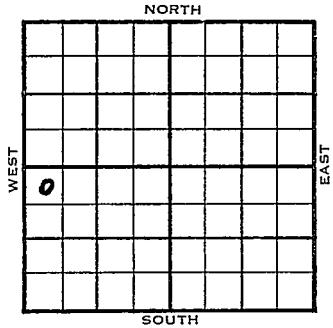

NW NW SW

	ELEVATION	REPORT
1955	2182'	
4/13	Spud 4-7-55 8" @ 161' Anhy 1609' Drlg. 2250'	
4/27	Spud 4-7-55 D & A TD 3765' 8" @ 161' Anhy 1609' Heeb. 3388', Tor. 3408' Lans. 3426' B KC 3635' Cong. 3673', Arb. 3740' TD 3765' D & A	

ABANDONED

