


Section 32 Township 9 Range 19 W

Well No. # 2 Lynd

Company Jones, Shelborne & Farmer

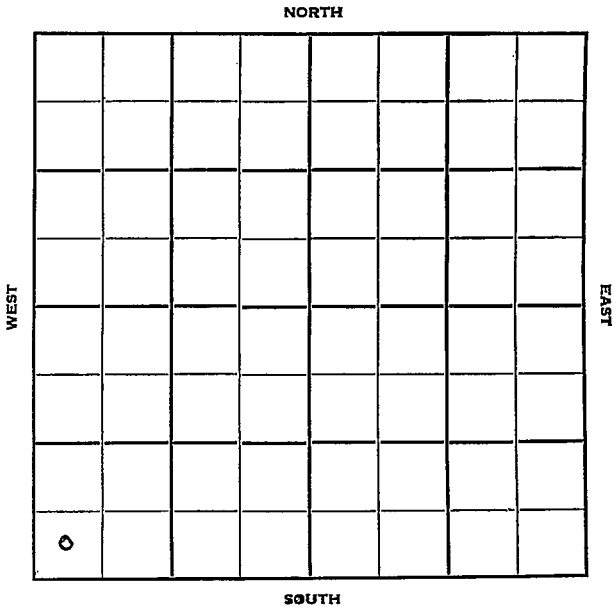

Rooks

KANSAS

Sec. 32 Twp. 9 R. 19W ✓

Well No. #2 Lynd Farm

Jones, Shelborne & Farmer Company

J S F Contractor

Lynd Pool

Ft. from N. Line

330


Ft. from S. Line

Ft. from E. Line

330

Ft. from W. Line

SW SW SW

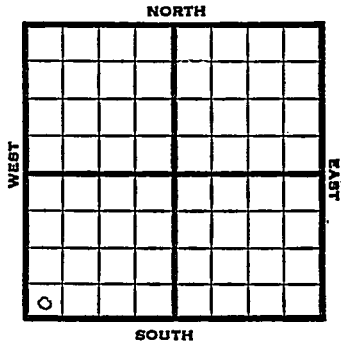

1951 Elev. 2216' REPORT

10/3

Spud 9-25-51
8" @ 155
1640 Anhy
Drlg. 3458

10/10

Spud 9-25-51
Spud 9-25-51
D&A TD 3820
8" @ 155
Anhy 1640
Heeb. 3424
Lans. 3467
DST 3622-36 opn 1/2 hr
Rec. 8' mud
Arb. 3781-3820 TD
D&A

ABANDONED

