
O. W. P. B KANSAS Graham

FORM 51 25M 3-49 PETROL

Section 32 Township ~~10~~ 9 Range 21-W

Well No. #1 Denning

Company ~~Westgate-Greenland~~ Natural Gas + Oil

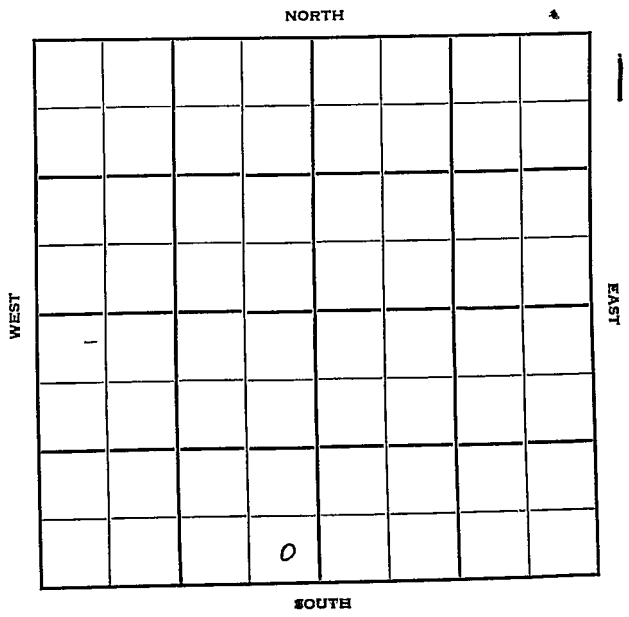

FORM 252-B
10M 9-49 PETROL

Graham KANSAS

Sec. 32 Twp. ~~10~~ 9 S. R. 21W

Well No. #1 Denning Farm

Westgate-Greenland Company

~~Wildcat~~ Contractor


_____ Ft. from N. Line

330' Ft. from S. Line

330' Ft. from E. Line

_____ Ft. from W. Line

SE SE SW

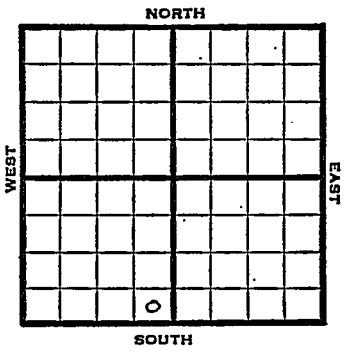

1950	Elev. 2273' REPORT
4/5	Location
5/24	10-3/4" @ 201' Anhy 1753' DST 3422-39 opn 1 hr Rec. 330' oil 630' wtr Heebner 3450' Lans. 3490' DST 3684-97 opn 1 hr Rec. 140' oil 150' wtr Arb. 3828-32 7" @ 3830 DD 3834 2600' oil Swab 100 bbls 500 acid Comp. 3000 BOPD TD 3834' COMPLETED

3828
2273
1555

Form 26 200 Bks. 11-49 Petrol

Kansas

Wildcat

Map No. ____ Sec. 32 Twp. 10- R. 21W


Well No. 1 Denning

Westgate-Greenland Company

Contractor

SE SE SW

SECTION PLAT

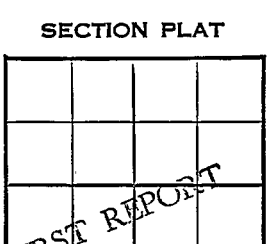

____ Ft. from N. Line

330 Ft. from S. Line

330 Ft. from E. Line

____ Ft. from W. Line

Graham County

Location x

Rig up

Drilling and Remarks:

RECORD

Cased ____ in., ____ ft.

Sand

Gas

Oil

Total Depth

PRODUCTION

1st 24 hrs. Nat.

1st 24 hrs. after shot

Gas ____ Cu. Ft.

Dry Hole

Abandoned

Date

APR 5 1950 19

J. E. TYRA Scout

Form 26 200 Bks. 11-49 Petrol

Wildcat

Map No. _____ Sec. 32 Twp. 9 R. 21W

Well No. 1 Denning


Westgate-Greenland Company

CORRECTION Contractor

SE SE SW

El. 2273

SECTION PLAT

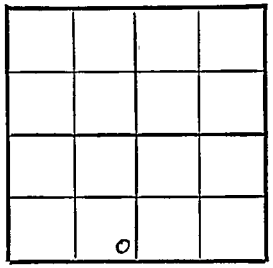

_____ Ft. from N. Line

330 Ft. from S. Line

330 Ft. from E. Line

_____ Ft. from W. Line

Graham County

Location _____

Rig up _____

Drilling and Remarks:

Reported

32-10-21W

RECORD

Cased _____ in., _____ ft.

Sand _____

Gas _____

Oil _____

Total Depth _____

PRODUCTION

1st 24 hrs. Nat. _____

1st 24 hrs. after shot _____

Gas _____ Cu. Ft.

Dry Hole _____

Abandoned _____

Date

APR 12 1950

19

J. E. TYRA Scout

Form 26 200 Bks. 11-49 Petrol

Wildcat

Kansas

Map No. _____ Sec. 32 Twp. 9 R. 21W

Well No. 1 Denning


Westgate-Greenland Company

Contractor

SE SE SW

El. 2273

SECTION PLAT

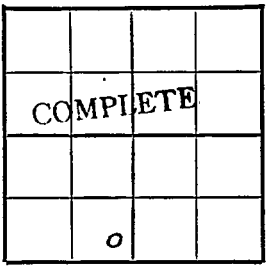

_____ Ft. from N. Line

330 Ft. from S. Line

330 Ft. from E. Line

_____ Ft. from W. Line

Graham

Location _____

Rig up _____

Drilling and Remarks:

10¾" @ 201
Anhy 1753
DST 3422-39
open 1 hr;
Rec. 330' oil
630' water
Kiebner 3450
Lans. 3490

RECORD

Cased _____ in., _____ ft.

Sand _____

Gas _____

Oil _____

Total Depth 3834

PRODUCTION

1st 24 hrs. Nat. _____

1st 24 hrs. after shot _____

Gas _____ Cu. Ft.

Dry Hole _____

Abandoned _____

Date

MAY 24 1950 19

J. E. TYRA Scout

DST 3684-97
Open 1 hr.
Rec. 140' oil
150' water
arb. 3828-32
7" @ 3830
DD. 3834
2600' oil
Swab: 100 bo
500 gal acid
Comp 3000 hrs

Scout Cards
Land Small Map
Land Wall Map
Tractings
Fraize Map
Pierce Map
Misc.

JUN 5 1950

O. W. P. B.

FORM 513 SUNRAY

County Graham Elev. 2273 DF

Sec. 32 Twp. 9 Rge. 21W

Company Natural Gas & Oil

Farm Name Denning No. 1

TOPS	DEPTH	LOG	DATUM
Anh.			
Tp.			
H.			
Tr.			
Dg.			
Bl.			
L. ans	3490		
K.C.			
B.K.C.			
Ce.			
C.			
M.			
M.			
K.			
Mz.			
Mo.			
V.			
S.			
S.			
Arb.	3828		
R.			
Pe.			
G.			
T.D. OTD	3834		

Loc. in Sec. SE SE SW

(O.W.P.B.)

Geol. O.W.P.B.

Contr.

Pool Cooper

FIRST REPORT

R-6-57

Date Comm.

7" @ 3830, Arb well, Comp 5-24-50.

New Infro. CO Set plug @ 3604, perf/3574-78 & perf/3528/34, Dakata wtr, broke in. Sq.

Co. Lse. No. Sec. T.

FORM 513 SUNRAY

Co.

County Graham Elev. 2273 DF

Sec. 32 Twp. 9 Rge. 21W

Company Natural Gas & Oil

Farm Name Denning No. 1

TOPS	DEPTH	LOG	DATUM
Anh.			
Tp.			
H.			
Tr.			
Dg.			
Bl.			
L. ans	3490		
K.C.			
B.K.C.			
Ce.			
C.			
M.			
M.			
K.			
Mz.			
Mo.			
V.			
S.			
S.			
Arb.	3828		
R.			
P€.			
G.			
T.D. OTD	3834		

Loc. in Sec. SE SE SW

(O.W.P.B.)

Geol.

Contr.

Lse.

Pool Cooper

APR 17 '57

COMPLETE

0

No.

Sec.

T.

R.

Date Comm.

7" @ 3830, Arb well, Comp 5-24-50

New Infro. CO Set plug @ 3606, perf/3574-78

& perf/3528/34, Dakata wtr, broke in. Sq.

MAR 13 '57 MAR 25 MAR 27 '57 APR 3 '57 /3

Pop P. 55 BO in 24 hrs

P. 65 BO + 20 BW 24 hrs

APR 10 '57 APR 17 '57 / Ph P. 83 Bopd

+ 48% wtr grav 35°