

Graham


KANSAS

Section 32 Township 9 Range 21WWell No. #2 DenningCompany Westgate Greenland

NORTH

WEST

EAST

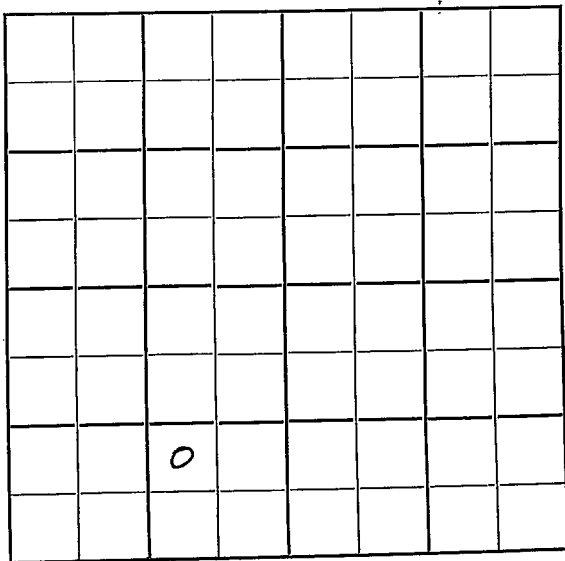

SOUTH

Duplicate

Sec. 32 Twp. 9 R. 21W

Well No. #2 Denning Farm

Westgate-Greenland Company

Jackson Drlg. - Contr. Contractor


Smith-Denning Pool NORTH

 Ft. from N. Line

990' Ft. from S. Line

990' Ft. from E. Line

 Ft. from W. Line

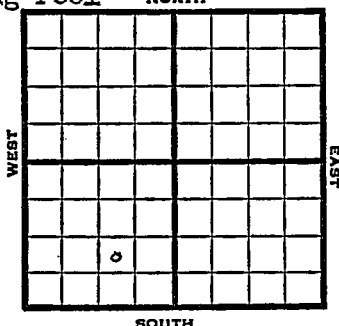

NW SE SW

1950 Elev. 2268' REPORT

5/3 Location

1951

1/31

Spud 5-10-50

9-5/8" @ 203 Anhy 1748'

KC 3495' Cong. 3783'

Arb. 3846'

DST 3846-55 opn 1 hr

Rec 30' ocm 5" @ 3848

TD 3857 B/15 goph 500 A

S/6 boph 50% wtr 48/3530-45

1000 A P/80 bo 125 bw

Comp. 116 bopd 35% wtr.

COMPLETED

Kansas

Map No. _____ Sec. 32 Twp. 9 R. 21WWell No. 2 Denning


_____ Westgate-Greenland _____ Company

_____ Contractor
NW SE SWE1. 2268
SECTION PLAT

_____ Ft. from N. Line

990 Ft. from S. Line990 Ft. from E. Line

_____ Ft. from W. Line

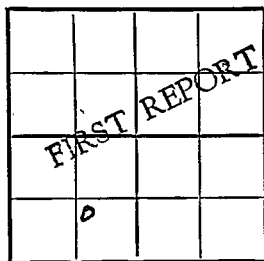

Graham County

Location X

Rig up _____

Drilling and Remarks: _____

RECORD

Cased _____ in., _____ ft.

Sand _____

Gas _____

Oil _____

Total Depth _____

PRODUCTION

1st 24 hrs. Nat. _____

1st 24 hrs. after shot _____

Gas _____ Cu. Ft.


Dry Hole _____

Abandoned _____

Date

MAY 3 1950 19 J. E. TYRA Scout

County Graham State Kansas
 Sec. 32 (Blk.) 9 (Sur.) 21W Map No.
 Operator Westgate-Greenland
 Well No. 2 Farm Denning
 Elev. 2268 Location NW SE SW

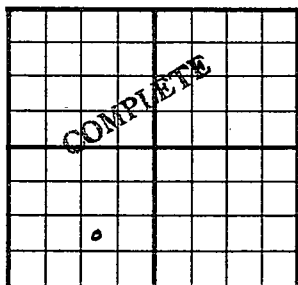

990 Ft. From S Line SW

990 Ft. From E Line Quarter

1st. Report

Completion JAN 31 1951

Remarks Smith-Denning Pool

Jackson Drlg. - Contr.

Spudding Date 5-10-50

Drlg. Data

9 5/8" @ 203 Anhy 1748 KC 3495

Cong. 3783 Arb. 3846 DST 3846-55

open 1 hr. Rec. 30' ocm 5" @ 3848

TD 3857 B/ 15 goph 500 A S/ 6 boph

50% water 48/ 3530-45 1000` A

P/ 80 bo 125 bw Comp. 116 bopd 35% water

J. E. TYRA