


Section 32 Township 9 Range 21 W

Well No. # 1 Early

Company Walters Drlg. Co. Inc

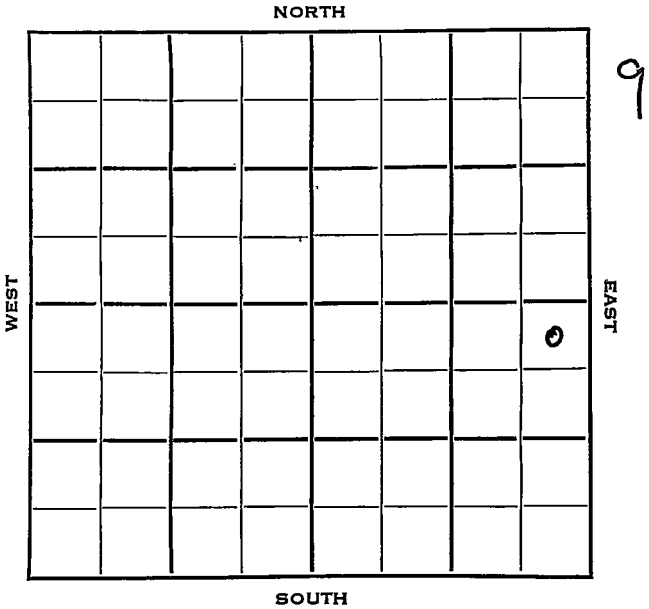

Graham **KANSAS** ✓  
9 R. 21W

Sec. 32 Twp. 9 R. 21W

Well No. #1 Early Farm

Walters Drlg. Co., Inc. Company

Walters Contractor


Wildcat

330 Ft. from N. Line

\_\_\_\_\_ Ft. from S. Line

330 Ft. from E. Line

\_\_\_\_\_ Ft. from W. Line

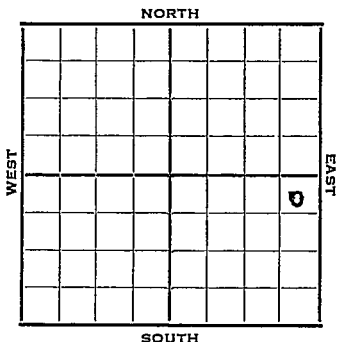

NE NE SE

DeepRock - FO

1953 Elev. 2338' REPORT

7/14 Spud 7-13-53  
7/22 8" @ 150 w/100  
Drlg. 3185'

7/29 Anhy 1808, Heeb 3535, Lans 3574,  
Arb 3915  
DST 3915-21, 1 hr., 45' OCM + some  
free oil, 730#  
RTD 3921  
5" @3916'

8/5 CO 3921, 500A  
S/3 bo 4 hrs.

8/12 Spud 7-13-53 D & A TD 3935  
8" @ 150 Anhy 1808 Heeb 3535  
Lans 3574 Arb. 3915  
DST 3915-21 open 1 hr rec 45' OCM 730#  
TD 3921 5" @ 3916 GO to 3921 500 A  
S/3 BO 4 hr. 2000 A FU 120' fluid  
3 BO ~~XXXXXXX~~ 8 BW 2 hr. DD 3925  
5 GO 58 GW 1 hr. DD 3931 B/1/2 BO  
1/2 BWPB DD 3935 FU 475' wtr. 1/2 hr.  
D & A

**ABANDONED**



