
FORM 51 25M 3-49 PETROL KANSAS Graham

Section 32 Township 9 Range 21-W

Well No. #2 Early

Company Deep Rock

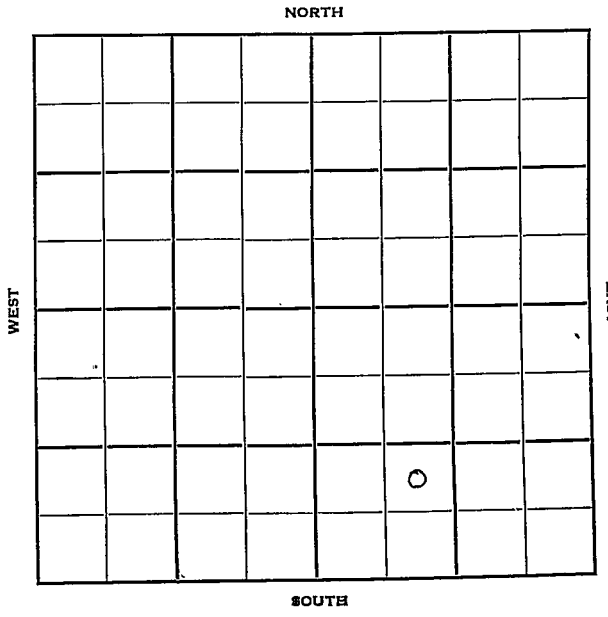

FORM 252-B
10M 9-49 PETROL

Graham KANSAS

Sec. 32 Twp. 9 R. 21W

Well No. #2 Early Farm

Deep Rock Company

Rine Drlg. Contractor

Smith-Denning Pool


____ Ft. from N. Line

990' Ft. from S. Line

____ Ft. from E. Line

990' Ft. from W. Line

NE SW SE

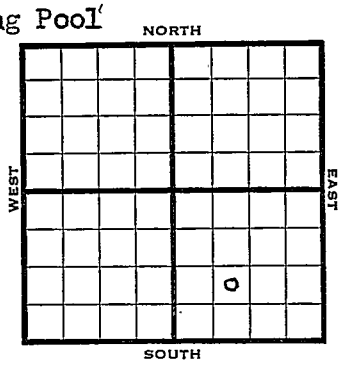

1950

REPORT

Elev 2311

7/5 Drlg.
7/19 10 3/4" @ 283
Top 3304
DST 3334-70, opn ½ hr rec 120' SW
Lans 3553
SO 3594-97
DST 3494-3600, opn ½ hr rec 680' SW
DST 3747-60, opn ½ hr rec 20' drlg mud
B KC 3784 Cong 3853
Arb 3908-23
DST 3908-13, opn 15 min rec 120 drlg mud
DST 3913-23, opn 1 hr rec 210' SW
Ran schlj
D&A

ABANDONED

Form 26 200 Bks. 11-49 Petrol Kansas Smith-Denning Poo

Map No. Sec. 32 Twp. 9 R. 21W

Well No. 2 Early

Deep Rock Company

Rine Drlg. Contractor

NE SW SE

Ft. from N. Line

990 Ft. from S. Line

Ft. from E. Line

990 Ft. from W. Line

SECTION PLAT



Gra'am County

Location

Rig up

Drilling and Remarks:

drlg.

RECORD

Cased in., ft.

Sand

Gas

Oil

Total Depth

PRODUCTION

1st 24 hrs. Nat.

1st 24 hrs. after shot

Gas Cu. Ft.

Dry Hole

Abandoned

Date

JUL 5 1950 19

J. E. TYRA Scout

Form 26 200 Bks. 11-49 Petrol

Kansas

Smith-Denning

Map No. _____ Sec. 32 Twp. 9 R. 21W

Well No. 2 Early


Deep Rock Company

Contractor

NE SW SE

El. 2311

SECTION PLAT

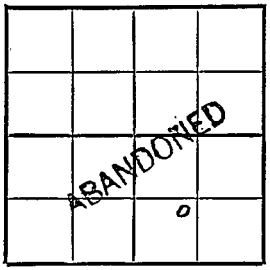

_____ Ft. from N. Line

990 Ft. from S. Line

_____ Ft. from E. Line

990 Ft. from W. Line

Graham County.

Location _____

Rig up _____

Drilling and Remarks:

10 3/4" @ 283
Top. 3304
DST 3334-70
open 1/2 hr.
Rec. 120' SW
Lans. 3553
SO 3594-97

RECORD

Cased _____ in., _____ ft.

Sand _____

Gas _____

Oil _____

Total Depth 3923

PRODUCTION

1st 24 hrs. Nat. _____

1st 24 hrs. after shot _____

Gas _____ Cu. Ft.

Dry Hole _____

Abandoned _____

Date

JUL 19 1950

19

J. F. TYRA Scout

DST 3494-3600

open 1/2 hr.

Rec. 680' SW

DST 3747-60

open 1/2 hr.

Rec. 20' drlg. mud

B. KC 3784

Cong. 3853

Arb. 3908-23

DST 3908-13

open 15 min.

Rec. 12' drlg. mud


DST 3913-23

open 1 hr.

Rec. 210' SW

Ran Schlumberger

D & A

 

Scout Cards
Land Small Map
Land Wall Map
Tracings
Trance Map
Pierce Map
Misc.