


Section 32 Township 9 Range 21W

Well No. #1 Eickman

Company Jones, Shelborne & Farmer

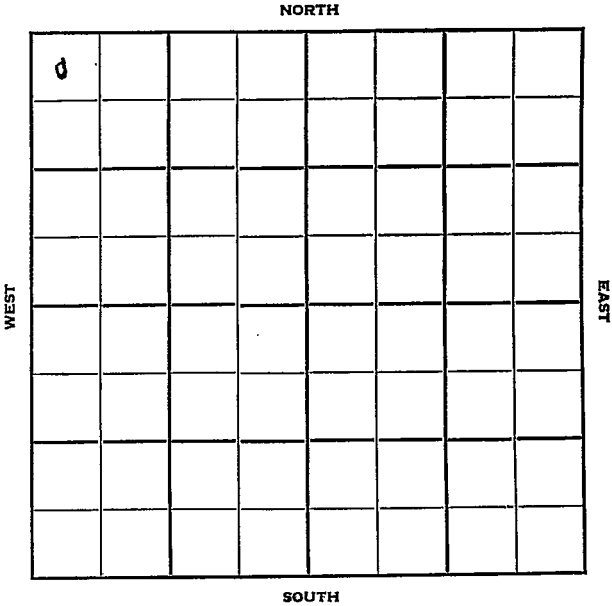

Sec. 32 Twp. 9 R. 21W

Well No. #1 Eickman Farm

Jones, Shelborne & Farmer Company

Contractor

Wildcat


330' Ft. from N. Line

_____ Ft. from S. Line

_____ Ft. from E. Line

330' Ft. from W. Line

NW NW NW

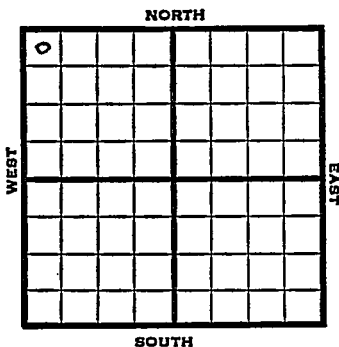

1951

Elev. 2317' REPORT

3/21

Spud 3-19-51
8" @ 180
WOC

4/4

D & A TD 3992'
8" @ 180' Anhy 1800', Heeb 3526',
Lans 3563', Cong 3922'
TD 3992' D & A
ABANDONED

County Graham State Kansas

Sec. 32 (Blk. Twp.) 9 (Sur. Rge.) 21W Map No.

Operator Jones, Shelborne & Farmer

Well No. 1 Farm Eickman

Elev. _____ Location NW NW NW

0					

330 Ft. From N Line NW

330 Ft. From W Line Quarter

1st. Report MAR 21 1951

Completion _____

Remarks _____

Spudding Date 3-19-51

Drlg. Data Wildcat

8" @ 180 WOC

County Graham State Kansas

Sec. 32 (Blk. 9) (Sur. 21W) (Twp. 9) (Rge. 21W) Map No.

Operator Jones, Shelborne & Farmer

Well No. 1 Farm Eickman

Elev. 2317 Location NW NW NW

0					

ABANDONED

330 Ft. From N Line NW

330 Ft. From W Line Quarter

Ist. Report

Completion APR 4 1951

Remarks Wildcat

Spudding Date

Drilg. Data D & A TD 3992

8" @ 180 Anhy 1800 Heeb. 3526

Lans. 3563 Cong. 3922 TD 3992

D & A