

Section 32 Township 9 Range 21WWell No. #1 J. A. EichmanCompany Alyward

NORTH

WEST

EAST

SOUTH

5

0

Graham

KANSAS
21W

Sec. 32 Twp. 9 R. 1

Well No. #1 J. A. Eichman Farm

Alyward Company

Alyward - Contr. Contractor


 Ft. from N. Line

330' Ft. from S. Line

 Ft. from E. Line

330' Ft. from W. Line

SW SW NW

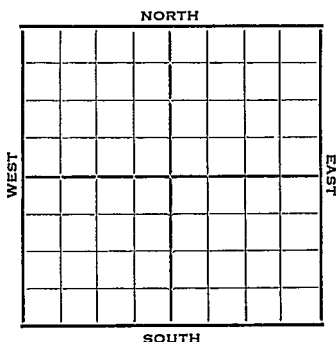


1952 Elev. 2305' REPORT

2/13 RUR

2/20 8" @ 215
Drlg. 3335'

2/27 Spud 2-12-52
D&A TD 3962
8" @ 215 Heeb. 3504 Lans. 3546
DST 3574-3602 open 1 hr. rec. 5' mud
DST 3715-66 open $\frac{1}{2}$ hr. rec. 11' drlg.
mud B KC 3769 Cong. 3894
TD 3962 D&A

ABANDONED

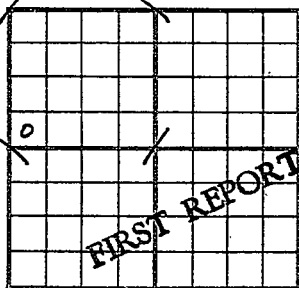County Graham State KansasSec. 32 (Blk. Twp.) 9 (Sur. Rge.) 21W Map No.Operator ~~Edward~~ AlwardWell No. 1 Farm J. A. EichmanElev. Location SW SW NW330 Ft. From S Line NW330 Ft. From W Line Quarter1st. Report FEB 13 1952

Completion

Remarks
~~Edward~~
Edward - Contr.


Spudding Date

Drlg. Data

RUR

J. G. McGEHEE

County Graham State Kansas
 Sec. 32 (Blk. 9 (Sur. 21W Map No.
 (Twp.) (Rge.)
 Operator Aylward Drlg. & Derby Oil
 Well No. 1 Farm J. A. Eichman
 Elev. 2305 Location SW SWNW

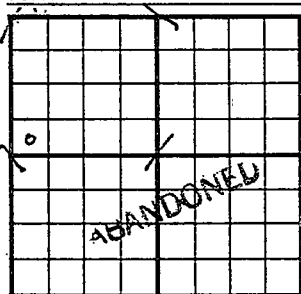

330 Ft. From S Line NW

330 Ft. From W Line Quarter

1st. Report

Completion FEB 27 1952

Remarks

: Aylward - Contr.

Spudding Date 2-12-52

Drlg. Data D & A TD 3962

8" @ 215 Heeb. 3504 Lans. 3546

DST 3574-3602 open 1 hr. Rec. 5' mud

DST 3715-66 open $\frac{1}{2}$ hr. Rec. 11' drlg.

mud B KC 3769 Cong. 3894 TD 3962

D & A

J. G. McGEHEE