

Graham


KANSAS

FORM 51 25M 3-49 PETROL

Section 32 Township 9S Range 21W

Well No. #1 Early

Company Deep Rock

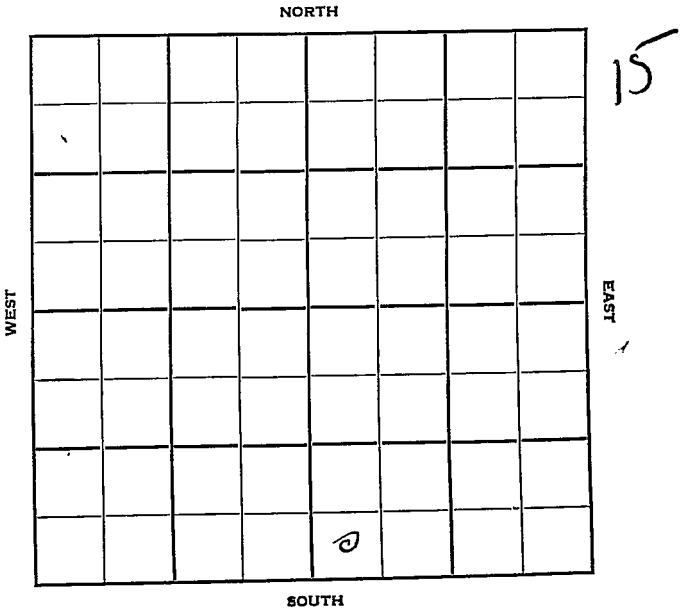

Sec. 32 Twp. 9-S R. 21-W

Well No. #1 Early Farm

Deep Rock Company

Rine Drlg. Contractor

Smith Denning


         Ft. from N. Line

330 Ft. from S. Line

         Ft. from E. Line

330 Ft. from W. Line

SW SW SE

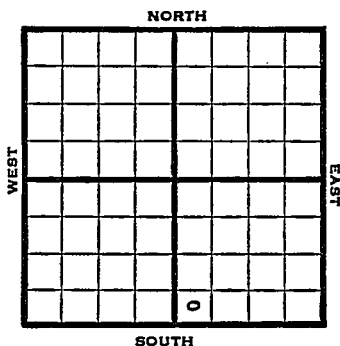

1950 Elev 2300

REPORT

6/7 Rig Up

8/23 8" @ 280

Anhy 1770 Top 3289

DST 3447-56 opn 30 min rec 30' socm

DST 3457-73 opn 40 min rec 20' socm

Heeb 3480 Dodge 3500

Lans 3520

DST 3553-70 opn 1/2 hr rec 1290' oil

180' muddy oil

Arb 3856-60

5" @ 3858

CO to 3860 TD

S/8 boph FU 2200' oil 8 hr

S/72 bo 4 hr

Comp 135 bopd 2% wtr

Completed

**COMPLETED**

Map No. \_\_\_\_\_ Sec. 32 Twp. 9S R. 21W

Well No. 1 Early

Deep Rock Company

Rine Drlg. Contractor

SW SE

SECTION PLAT

FIRST REPORT			

\_\_\_\_\_ Ft. from N. Line

330 Ft. from S. Line

\_\_\_\_\_ Ft. from E. Line

330 Ft. from W. Line

Graham

Location \_\_\_\_\_

Rig up X

Drilling and Remarks:

RECORD

Cased \_\_\_\_\_ in., \_\_\_\_\_ ft.

Sand \_\_\_\_\_

Gas \_\_\_\_\_

Oil \_\_\_\_\_

Total Depth \_\_\_\_\_

PRODUCTION

1st 24 hrs. Nat. \_\_\_\_\_

1st 24 hrs. after shot \_\_\_\_\_

Gas \_\_\_\_\_ Cu. Ft.

Dry Hole \_\_\_\_\_

Abandoned \_\_\_\_\_

Date

JUN 7 1950

19

J. E. TYRA Scout

