

Graham

KANSAS

SECTION 32 TOWNSHIP 9 RANGE 22 W

WELL NO. #2 Farrell

COMPANY K & E Drlg.

NORTH

WEST

EAST

0							

SOUTH

5

Graham

KANSAS

SEC. 32	TWP. 9	R. 22W
------------	-----------	-----------

WELL NO.

#2 Farrell

FARM

COMPANY

K & E Drlg.

CONTRACTOR

Co. Tools


Redline Ext.

Ft. from N. Line

Ft. from S. Line

Ft. from E. Line

Ft. from W. Line

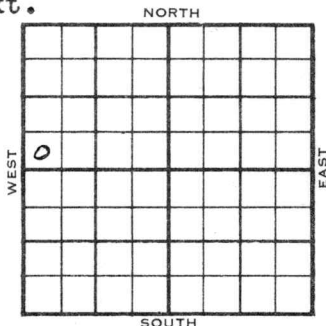

SW SW NW

~~SDX~~ SDX $\frac{1}{2}$ mile

1956	ELEVATION 2356	REPORT
1-11	MIR	
1-19	Spud 1-11-56 8 5/8" @ 218/140, Anhy 1903 Heeb. 3596, Tor. 3617 Lans. 3627 Drlg. 3640	3627 2356 71
1-26		
1-26	DST 3772-92 op 1 hr. rec. 8' mud, 0# DST 3788-3818 op 1 hr. rec. 2' mud, 0# D & A BKC 3854 TD 3860'	

ABANDONED

County Graham Elev. _____ Co.
 Sec. 32 Twp. 9 Rge. 22W
 Company X & E Drilg.
 Farm Name Farrell No. 2

TOPS	DEPTH	LOG	DATUM	Loc. in Sec.
Anh.				SW SW NW
Tp.				
H.				
Tr.				
Dg.				
B.L.				
L.				
K.C.				Geol. _____
B.K.C.				Contr. _____
Ce.				Co. tools _____
C.				Pool _____
M.				Redline Ext. _____
M.				
K.				
Mz.				
Mo.				
V.				
S.				
S.				
A.				
R.				
Pe.				
G.				
T.D.				

1/2 mile

JAN 11 '58

FIRST REPORT

Date Comm.

M I R

S

County Graham Elev. 2356
 Sec. 32 Twp. 9 Rge. 22W
 Company K & E Drlg.
 Farm Name Farrell No. 2

TOPS	DEPTH	LOG	DATUM	Loc. in Sec.
Anh.	<u>1903</u>			<u>SW SW NW</u>
Tp.				
H.	<u>3596</u>			
Tr.	<u>3617</u>			
Dg.				
BL.				
L.	<u>3627</u>		<u>1271</u>	Geol.
K.C.				Contr.
B.K.C.	<u>3854</u>		<u>1498</u>	
Ce.				<u>Co. tools</u>
C.				
M.				
M.				
K.				<u>Pool</u>
Mz.				<u>Redline</u>
Mq.				
V.				
S.				
S.				
A.				
R.				
Pe.				
G.				
T.D.	<u>3860</u>			

ABANDONED

Date Comm. 1-11-56 JAN 25 1956

8 5/8" @ 218/140 DST 3772-92

open 1 hr. rec. 8' mud O#

DST 3788-3818 open 1 hr. rec. 2' mud

O#

D & A

2356

1903

433