

Graham

KANSAS

SECTION 32 TOWNSHIP 9 RANGE 25 W

WELL NO. #1 Brungardt "A"

COMPANY Heathman & Seeligson

NORTH

				0			

WEST

EAST

SOUTH

Graham

KANSAS

SEC.	TWP.	R.
32	9	25W

WELL NO.

#1 Brungardt "A"

FARM

COMPANY

Heathman & Seeligson

CONTRACTOR

Co Tools


Wildcat

_____ Ft. from N. Line

_____ Ft. from S. Line

_____ Ft. from E. Line

_____ Ft. from W. Line

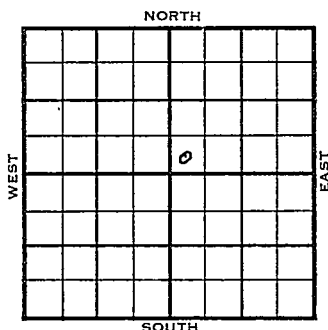

SW SW NE

Amerada Support

	ELEVATION	REPORT
1955	2585'	

11/9 ~~X~~ Loc~~#####~~

11-23

Comm. 11-9-55

8 5/8" @ 200/125

DST 3537-85 op 45 min. rec. 3' mud,
100#DST 4020-40 op 1 hr. rec. 20' mud.
580#

DST 4045-63, failed.

DST 4044-63 op 2 hrs. rec. 65' msw,
180#

D & A

Anh. 2227'

H. 3826'

Tr. 3850'

L. 3864'

B.K.C. 4096'

Marm 4144'

Marm ch. 4195'

Marm Ch. Cong. 4410'

Chert 4422'

TD 4425'

ABANDONED

County Graham

Elev. _____

Sec. 32Twp. 9Rge. 25WCompany Heathman & SeeligsonFarm Name Brungardt "A"No. 1

TOPS

DEPTH

LOG

DATUM

Loc. in Sec. _____

Anb. _____

Tp. _____

H. _____

Tr. _____

Dg. _____

Bl. _____

L. _____

K.C. _____

B.K.C. _____

Ce. _____

C. _____

M. _____

M. _____

K. _____

Mz. _____

Mq. _____

V. _____

S. _____

S. _____

A. _____

R. _____

Pe. _____

G. _____

G. _____

T.D. _____

SW SW NE

Geol. _____

Contr. _____

Co. tools

Pool

Wildcat

NOV 9 '85

O

FIRST REPORT

Date Comm. _____

Amerada Support

Location

Co.

Lse.

No.

Sec.

T.

R.

County Graham Elev. 2585
 Sec. 32 Twp. 9 Rge. 25W
 Company Heathman & Seeligson
 Farm Name Brungardt "A" No. 1

TOPS	DEPTH	LOG	DATUM	Loc. in Sec.
Anh.	2227			SW SW NE
Tr.				
H.	3826		1241	
Tr.	3850		1265	
Dg.				
BL				
L.	3864		1279	Geol.
K.C.				
B.K.C.	4096		1511	Contr.
Ce. <u>Marm.</u>	4144		1559	Co. tools
C. " <u>Ch.</u>	4195		1616	
M. " <u>Ch. Comp.</u>	4410		1825	Pool
M. <u>Phont</u>	4422		1837	
K.				Wildcat
Mz.				
Ma.				
V.				
S.				
S.				
A.				
R.				
Pe.				
G.				
T.D.	4425			

ABANDONED

Date Comm. 11-9-55 NOV 23 1955
8 5/8" @ 200/125 DST 3537-85 open 45 min
rec. 3' mud 100# DST 4020-40 open
1 hr. rec. 20' mud 580# DST 4045-63
failed DST 4044-63 open 2 hr.
rec. 65' muddy sw 180#

D & A