


Section 32 Township 9 Range 26W

Well No. 38 Strat

Company Continental

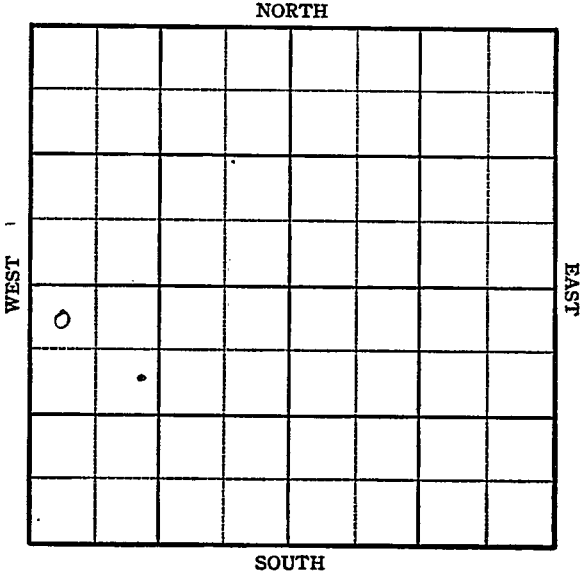

Sec. 32 Twp. 9 R. 26-W

Well No. #38 Strat Farm _____


Continental Company

330 Ft. from N. Line

_____ Ft. from S. Line

_____ Ft. from E. Line

330 Ft. from W. Line

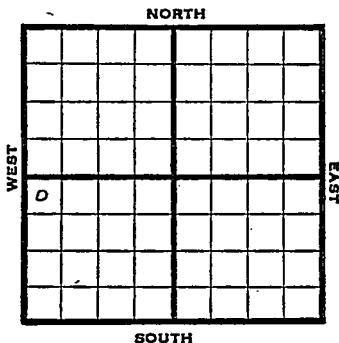

NW SW

1945 Elev. 2673 REPORT

11/7 Drlg.

11/14 "

11/21 "

11/28 "

12/5 "

12/12 "

12/20 "

12/29 "

1946

1/9 No tops or depth

ABANDONED

WINDOAS

Kansas Pool Name Wildcat

Map No. 67 Sec. 32 Twp. 9 R. 26W

Well No. 38 Strat

Continental Company

FIRST REPORT

Contractor

NW SW

SECTION PLAT

330 Ft. from N. Line

_____ Ft. from S. Line

_____ Ft. from E. Line

330 Ft. from W. Line

| | | | |
|---|--|--|--|
| | | | |
| | | | |
| o | | | |
| | | | |

Sheridan County

Location _____

Rig up _____

Drilling and Remarks:
drlg.

RECORD

Cased _____ in, _____ ft.

Sand _____

Gas _____

Oil _____

Total Depth _____

PRODUCTION

1st 24 hrs. Nat. _____

1st 24 hrs. after shot _____

Gas _____ Cu. Ft.

Dry Hole _____

Abandoned _____

Date

NOV 7 1945 19

S. J. LEWIS Scout

KANSAS Kansas Pool Name WildcatMap No. 67 Sec. 32 Twp. 9 R. 26WWell No. 38 StratContinental CompanyABANDONED

Contractor

F. 2623

NW SW

SECTION PLAT

330 Ft. from N. Line

_____ Ft. from S. Line

_____ Ft. from E. Line

330 Ft. from W. Line

| | | | |
|---|--|--|--|
| | | | |
| | | | |
| 0 | | | |
| | | | |

Sheridan County

Location _____

Rig up _____

Drilling and Remarks:

*No tops or
Dip.*

RECORD

Cased _____ in., _____ ft.

Sand _____

Gas _____

Oil _____

Total Depth _____

PRODUCTION

1st 24 hrs. Nat. _____

1st 24 hrs. after shot _____

Gas _____ Cu. Ft.

Dry Hole _____

Abandoned LOC

Date

JAN 9 1946 19S. J. LEWIS Scout