

18-9-32W Inc

STATE CORPORATION COMMISSION OF KANSAS
OIL & GAS CONSERVATION DIVISION
WELL COMPLETION OR RECOMPLETION FORM
ACO-1 WELL HISTORY
DESCRIPTION OF WELL AND LEASE

5

API No. 15-193-20,459
County Thomas
SE NE SE Sec 18 Twp 9S Rge 32 East
West

Operator: License # 5123 & 4277
Name Pickrell Drlg Co. & Bruce Anderson
Address 110 N. Market
Suite 205
City/State/Zip Wichita, KS 67202

1900 Ft North from Southeast Corner of Section
540 Ft West from Southeast Corner of Section
(Note: Locate well in section plat below)

Purchaser None

Lease Name Steinle Well # 1-B

Operator Contact Person Ted Sandberg
Phone 263-5544

Field Name Wildcat

Contractor: License # 5123
Name Pickrell Drilling Company, Inc.

Producing Formation None

Wellsite Geologist George Mueller
Phone 262-7181


Elevation: Ground 3051 KB 3056

Designate Type of Completion
 New Well Re-Entry Workover

Oil SWD Temp Abd
 Gas Inj Delayed Comp.
 Dry Other (Core, Water Supply etc.)

If ONWO: old well info as follows:
Operator
Well Name
Comp. Date Old Total Depth

Section Plat

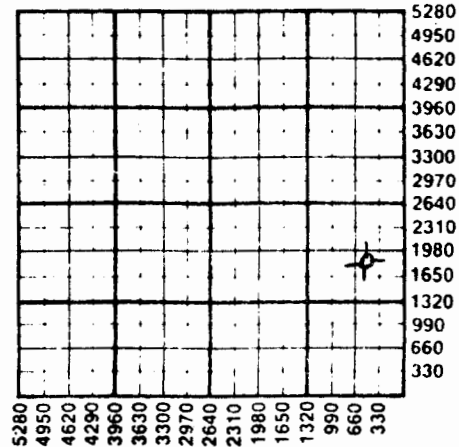

WATER SUPPLY INFORMATION

Disposition of Produced Water: Disposal
Docket # Repressuring

WELL HISTORY
Drilling Method:
 Mud Rotary Air Rotary Cable

12-18-87 12-31-87 12-31-87
Spud Date Date Reached TD Completion Date

4725' ---
Total Depth PBDT

Amount of Surface Pipe Set and Cemented at 315 feet
Multiple Stage Cementing Collar Used? Yes No
If yes, show depth set feet
If alternate 2 completion, cement circulated
from feet depth to w/ SX cmt
Cement Company Name
Invoice #

Questions on this portion of the ACO-1 call:
Water Resources Board (913) 296-3717
Source of Water: T 87-569
Division of Water Resources Permit #
 Groundwater 1520 Ft North from Southeast Corner
(Well) 1520 Ft West from Southeast Corner of
Sec 18 Twp 9S Rge 32 East X West
Surface Water Ft North from Southeast Corner
(Stream, pond etc) Ft West from Southeast Corner
Sec Twp Rge East West
Other (explain)
(purchased from city, R.W.D. #)

INSTRUCTIONS: This form shall be completed in triplicate and filed with the Kansas Corporation Commission, 200 Colorado Derby Building, Wichita, Kansas 67202, within 120 days of the spud date of any well. Rule 82-3-130, 82-3-107 and 82-3-106 apply.
Information on side two of this form will be held confidential for a period of 12 months if requested in writing and submitted with the form. See rule 82-3-107 for confidentiality in excess of 12 months.
One copy of all wireline logs and drillers time log shall be attached with this form. Submit CP-4 form with all plugged wells. Submit CP-111 form with all temporarily abandoned wells.