

P1  
26-9-32400

STATE CORPORATION COMMISSION OF KANSAS  
OIL & GAS CONSERVATION DIVISION

WELL COMPLETION OR RECOMPLETION FORM  
ACO-1 WELL HISTORY

DESCRIPTION OF WELL AND LEASE

Operator: License # 7506  
Name First Energy Corporation  
Address 16701 Greenspoint Pk. Dr.  
#200  
City/State/Zip Houston, TX 77060

Purchaser.....

Operator Contact Person Gayle Carter  
Phone 713-875-5755

Contractor: License # 5422  
Name Abercrombie Drilg., Inc.

Wellsite Geologist James K. Price  
Phone 303-293-8080

Designate Type of Completion  
 New Well  Re-Entry  Workover  
 Oil  SWD  Temp Abd  
 Gas  Inj  Delayed Comp.  
 Dry  Other (Core, Water Supply etc.)

If OWN: old well info as follows:  
Operator.....  
Well Name.....  
Comp. Date.....Old Total Depth.....

WELL HISTORY

Drilling Method:  
 Mud Rotary  Air Rotary  Cable  
7/25/85 8/02/85 8/02/85  
Spud Date Date Reached TD Completion Date  
4695'  
Total Depth PBTD

Amount of Surface Pipe Set and Cemented at 365 feet  
Multiple Stage Cementing Collar Used?  Yes  No  
If yes, show depth set.....feet  
If alternate 2 completion, cement circulated  
from.....feet depth to.....w/.....SX cmt

API NO. 15-193-20,362

County Thomas

C NE NE SW Sec. 26 Twp. 9S Rge. 32  East  West

2310 Ft North from Southeast Corner of Section  
2970 Ft West from Southeast Corner of Section  
(Note: Locate well in section plat below)


Lease Name ALICE J. HOWARD ESTATE Well # 45-26 Well #

Field Name.....

Producing Formation.....

Elevation: Ground 3059' KB 3064'

Section Plat

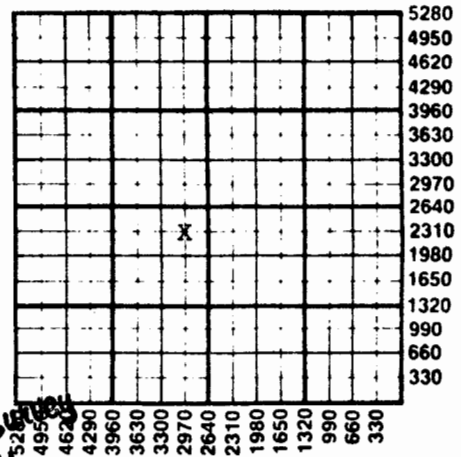

OCT 22 1985  
State Geological Survey  
WICHITA BRANCH

WATER SUPPLY INFORMATION

Disposition of Produced Water:  Disposal  Repressuring  
Docket # .....

Questions on this portion of the ACO-1 call:

Water Resources Board (913) 296-3717

Source of Water:  
Division of Water Resources Permit #.....

Groundwater 2400 Ft North from Southeast Corner  
(Well) 2940 Ft West from Southeast Corner of  
Sec 26 Twp 9S Rge 32  East  West

Surface Water.....Ft North from Southeast Corner  
(Stream, pond etc).....Ft West from Southeast Corner  
Sec Twp Rge  East  West

Other (explain).....  
(purchased from city, R.W.D. #)

INSTRUCTIONS: This form shall be completed in duplicate and filed with the Kansas Corporation Commission, 200 Colorado Derby Building, Wichita, Kansas 67202, within 90 days after completion or recompletion of any well. Rule 82-3-130 and 82-3-107 apply.

Information on side two of this form will be held confidential for a period of 12 months if requested in writing and submitted with the form. See rule 82-3-107 for confidentiality in excess of 12 months.

One copy of all wireline logs and drillers time log shall be attached with this form. Submit CP-4 form with all plugged wells. Submit CP-111 form with all temporarily abandoned wells.

26-9-32 W p1

SIDE TWO

Alice J. Howard Estate

45-26

1

Operator Name First Energy Corporation Lease Name Well #

Sec. 26 Twp. 9S Rge. 32 East West County Thomas

WELL LOG

INSTRUCTIONS: Show important tops and base of formations penetrated. Detail all cores. Report all drill stem tests giving interval tested, time tool open and closed, flowing and shut-in pressures, whether shut-in pressure reached static level, hydrostatic pressures, bottom hole temperature, fluid recovery, and flow rates if gas to surface during test. Attach extra sheet if more space is needed. Attach copy of log.

Drill Stem Tests Taken [X] Yes [ ] No
Samples Sent to Geological Survey [ ] Yes [ ] No
Cores Taken [ ] Yes [ ] No

Formation Description [X] Log [ ] Sample

DST #1 4240 - 4645' (Lansing)
30-60-30-90 BHT 103°F
IHP 2154 psi FFP 61 psi
IFP 51 psi FSIP 448 psi
ISIP 1176 psi FHP 2308 psi
Rec'd 5' drlg mud

Table with 3 columns: Name, Top, Bottom. Rows include Dakota, Topeka, Heebner, Lansing, Pleasanton, Pawnee, Cherokee, Mississippian.

DST #1 4585 - 4645' (Cherokee)
30-60-30-90 BHT 117°F
IHP 2411 psi FFP 81 psi
IFP 71 psi FSIP 448 psi
ISIP 592 psi FHP 2308 psi
Rec'd 15' oil spotted mud

OCT 22 1985


Form containing sections: CASING RECORD, Report all strings set-conductor, surface, intermediate, production, etc., PERFORATION RECORD, Acid, Fracture, Shot, Cement Squeeze Record, TUBING RECORD, Date of First Production, Producing Method.