


Section 33 Township 9 Range 5 W

Well No. # 1 Kien

Company Ververka Gassaway & Erdway

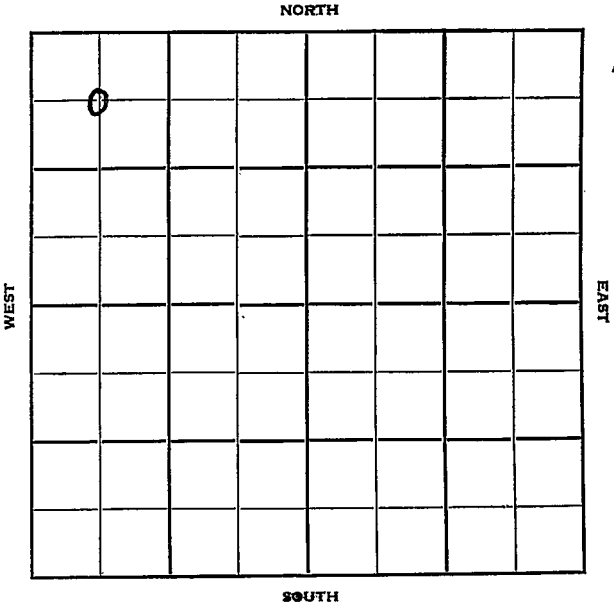

Ottawa

KANSAS

✓

Sec. 33 Twp. 9 R. 5 W

Well No. # 1 Kien Farm

Ververka Gassaway & Erdway Company

Mallard Drlg. Contractor

Wildcat


660 Ft. from N. Line

Ft. from S. Line

Ft. from E. Line

660 Ft. from W. Line

C NW NW

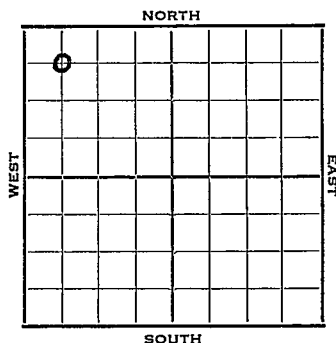

1952

Elev. -

R E P O R T

6/11

Spud 6-6-52

10" @ 170

Drlg. 1275'

6/18

Lans. 2560' B KC 2925' -

Cherokee 3108' Miss 3256'

Drlg. 3365'

6/25

Htn 3495' Mq shale 3562'

V. 3612' Simp. 3723' Arb. 3765' -

3781' RTD

7/2

Spud 6-6-52

D&A TD 3805' 10" @ 170'

Lans. 2560

B KC 2925

Cherokee 3108

Miss. 3256

Hunton 3495

Maq. 3562


Viola 3612

Simp. 3723

Arb. 3765

TD 3805' D&A

ABANDONED

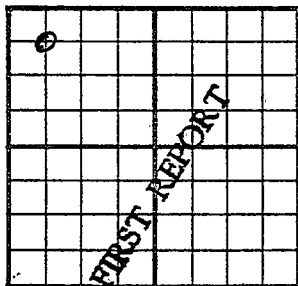County Ottawa State KANSASSec. 33 (Blk. Twp.) 9 (Sur. Rge.) 5W Map No.Operator Ververka Gassaway & ErdwayWell No. 1 Farm KienElev. Location C NW NW660 Ft. From N Line NW660 Ft. From W Line Quarter1st. Report JUN 11 1952


Completion

Remarks

Mallard Drlg. - Contr.Spudding Date 6-6-52Drlg. Data Wildcat10" @ 170 drlg. 1275

J. G. McGEHEE

County Ottawa State Kansas
 Sec. 33 (Blk. 1 Twp.) 9 (Sur. 5W Rge.) Map No.
 Operator Ververka Gassaway & Erdway
 Well No. 1 Farm Kien
 Elev. Location C NW NW

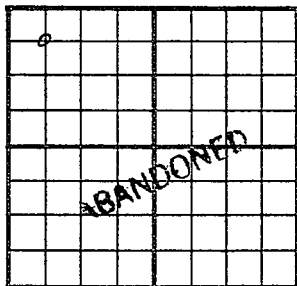

660 Ft. From N Line NW
 660 Ft. From W Line Quarter

1st. Report

Completion JUL 2 1952

Remarks Wildcat

Mallard Drlg. - Contr.

Spudding Date 6-6-52

Drlg. Data D & A TD 3805

10" @ 170 Lans. 2560 B KC 2925

Cherokee 3108 Miss. 3256 Hunton 3495

Maq. 3562 Viola 3612 Simp. 3723

Arb. 3765 TD 3805

D & A