


Section 33 Township 9 Range 16 W

Well No. # 1 Conger

Company Herndon Drlg.

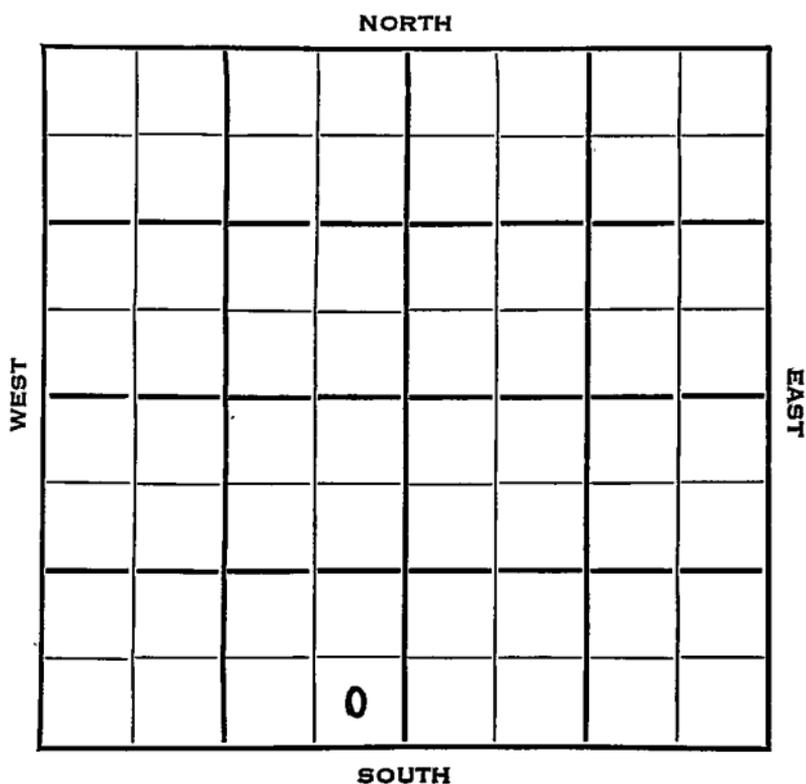

Sec. 33 Twp. 9 R. 16W

Well No. #1 Conger Farm \_\_\_\_\_

Herndon Drlg. Company \_\_\_\_\_

Herndon Drlg. Contractor \_\_\_\_\_

**Wildcat**


\_\_\_\_\_ Ft. from N. Line

330 Ft. from S. Line

330 Ft. from E. Line

\_\_\_\_\_ Ft. from W. Line

SE SE SW

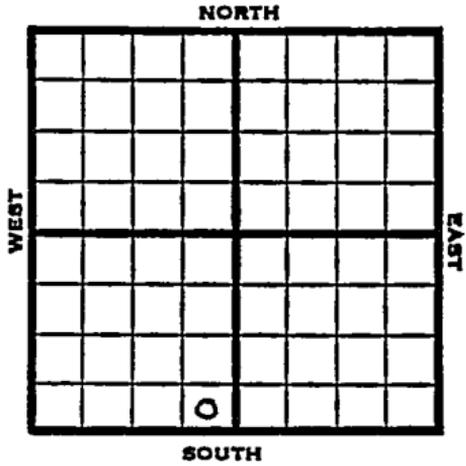

1953 Elev. 2038' REPORT

6/24 Spud 6-21-53  
Rng Surface.

7/1 8" @ 240  
Anhy 1220, Heeb 3146, Tor 3168,  
Lans 3187  
Drlg.

7/8 Spud 6-21-53  
D & A  
TD 3525'  
8" @ 240'  
Anhy 1220, Heeb 3146, Tor 3168, Lans  
3187, B KC 3412, Arb 3525  
TD 3525'  
D & A

**ABANDONED**



County \_\_\_\_\_ Rocks \_\_\_\_\_ State Kansas

Sec. 33 (Blk. Twp.) 9 (Sur. Rge.) 16W Map No. \_\_\_\_\_

Operator Herndon Drlg.

Well No. 1 Farm Conger

Elev. 2038 Location SE SE SW



330 Ft. From S Line SW

330 Ft. From E Line Quarter

Ist. Report \_\_\_\_\_

Completion JUL 8 1953

Remarks Wildcat

Herndon Drlg. - Contr.

Spudding Date 6-21-53

Drlg. Data D & A TD 3525

8" @ 240 Anhy 1220 Heeb. 3146

Tor. 3168 Lans. 3187 B KC 3412

Arb. 3525 TD 3525

D & A