

Sec. 33 Twp. 9 R. 17W ✓

Well No. #4 Carmichael Farm

Musgrove Petroleum Company

Contractor

Nettie Pool


Ft. from N. Line

330' Ft. from S. Line

Ft. from E. Line

330' Ft. from W. Line

SW SW SE

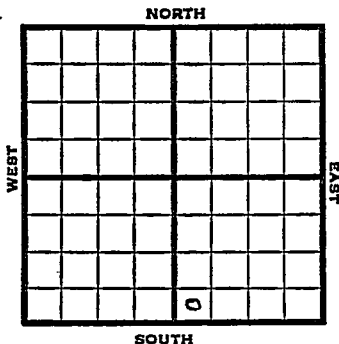

1951

Elev. 2107' REPORT

1/3

Drilg. 2500'

2/14

Oil Well TD 3546

Heeb. 3204 Toronto 3225'

Lans. 3248' Simp 3511'

Arb. 3536-39'

5" @ 3537'

TD 3542 S/1/2 boph 1500 A

S/1/2 boph DD 3546

Comp. 75 bopd 6% wtr.

COMPLETED

