

Section 33 Township 9 Range 17-W

Well No. #2 Schrandt


Company Palmer Oil

NORTH

O.W.W.O.

WEST

EAST

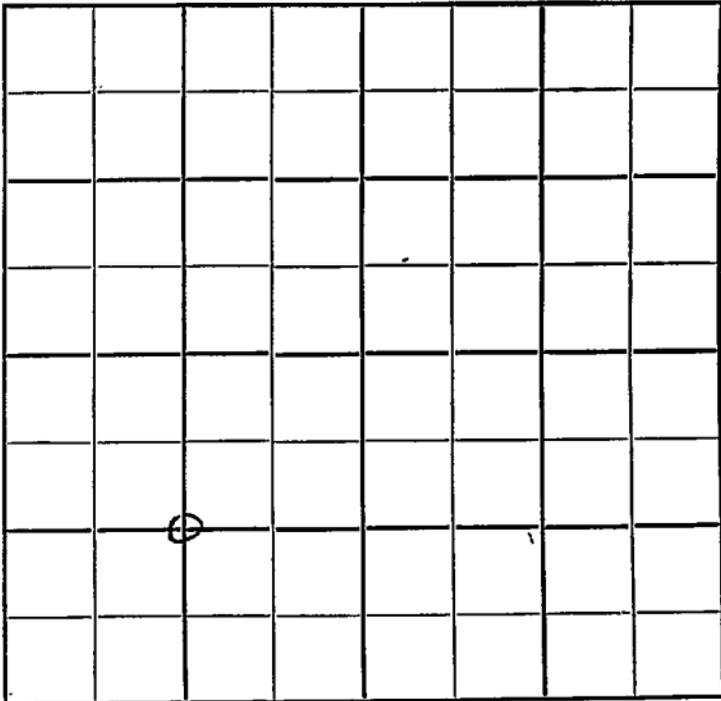

SOUTH

Sec. 33 Twp. 9 R. 17-W ✓

Well No. #2 Schrandt Farm
Palmer Oil Company
 Contractor

Nettie


 Ft. from N. Line

1386 Ft. from S. Line

 Ft. from E. Line

1320 Ft. from W. Line

C SW/4

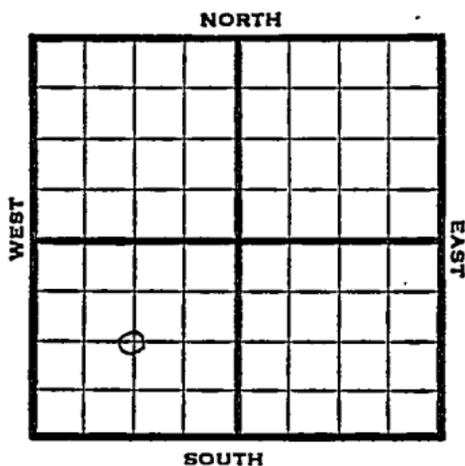

1950 Elev. 2091' REPORT

11/8 MIR

12/27 Spud 11-7-50
 Oil Well TD 3535
 8" @ 182
 Lans. 3230
 Arb. 3528-30
 5" @ 3529
 DD 3535 TD
 FU 500' oil 1 hr
 Comp. 575 bopd

COMPLETED

1952

O.W.W.O.

7/30 Oil Well TD 3535
 Lans. 3230 Arb. 3528
 OTD 3535 5" @ 3529
 PB 3410 29/3400-05 2000 A
 Comp. 141 BOPD

**FIRST REPORT
 &
 COMPLETED**

County _____ Rocks _____ State Kansas

Sec. 33 (Blk.) _____ 9 (Sur. Rge.) 17W Map No. _____

Operator Palmer Oil

Well No. 2 Farm Schrandt

Elev. 2091 Location C SW/4

COMPLETE

1386Ft. From S Line SW

1320Ft. From W Line Quarter

Ist. Report _____

Completion DEC 27 1950

Remarks Nettie Pool

Spudding Date 11-7-50

Drlg. Data Oil well TD 3535

8" C 182 Lans. 3230 Arb. 3528-30

5" C 3529 DD 3535 TD FU-500' oil 1 hr.

Comp. 575 bond

J. E. TYRA

O.W.W.O.

County Rooks State Kansas

Sec. 33 (Blk. 9) (Sur. 17W) Map No.

Operator Palmer Oil

Well No. 2 Farm Schrandt

Elev. 2091 Location C SW/4

1320 Ft. From N Line SW

1320 Ft. From W Line Quarter

Ist. Report JUL 30 1952

Completion JUL 30 1952

Remarks O.W.W.O.
O.W.W.O.

Spudding Date

Drlg. Data Oil well TD 3535

Lans. 3230 Arb. 3528 OTD 3535 5" @

3529 PB 3410 29/ 3400-05 2000 A

Comp. 141 bopd

J. G. McGEHEE