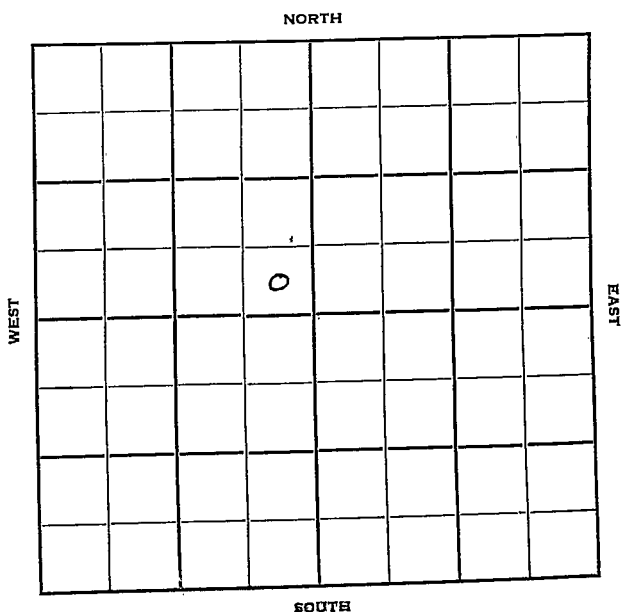


Section 33 Township 9 Range 17-WWell No. #1 WesthusinCompany Berwick & Isern

Rooks **KANSAS**

Sec. 33 Twp. 9 R. 17W

Well No. #1 Westhusin Farm

Berwick & Isern Company

Keyes Drlg. Contractor

Nettie


 Ft. from N. Line

330' Ft. from S. Line

330' Ft. from E. Line

 Ft. from W. Line

SE SE NW

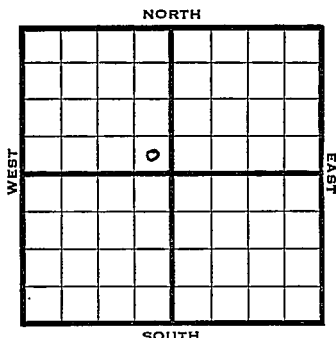

1950

Elev 2109

REPORT

6/28

Spud 6-21-50

8" @ 200'

Anhy 1360-90

Drlg. 2705'

10/4

8" @ 200

Anhy 1360-90

Lans 3258

Simp 3550

Arb 3552

DST 3554-58 bpn 1 hr rec 250' oil
20 gr.

5" @ 3554

TD 3558

FU 2400' oil 6 hr

S/200 bo 6 hr

Comp 90 bopd 18% water

Completed

COMPLETED

Map No. _____ Sec. 33 Twp. 9 R. 17WWell No. 1 West husinBerwick & Isern

Company

Contractor

SE SE NW

_____ Ft. from N. Line

330 Ft. from S. Line330 Ft. from E. Line

_____ Ft. from W. Line

SECTION PLAT



Rooks County

Location _____

Rig up _____

Drilling and Remarks:

Spud 6-21-50

8" C 200

Anhy 1360-90

drlg. 2705

RECORD

Cased _____ in., _____ ft.

Sand _____

Gas _____

Oil _____

Total Depth _____

PRODUCTION

1st 24 hrs. Nat. _____

1st 24 hrs. after shot _____


Gas _____ Cu. Ft.

Dry Hole _____

Abandoned _____

Date

JUN 28 1950 19 J E TVE Scout

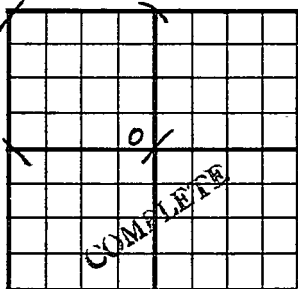County Rooks State KansasSec. 33 (Blk. Twp.) 9 (Sur. Rge.) 17W Map No.Operator Burwick & IsernWell No. 1 Farm WesthusinElev. 2109 Location SE SE NW330 Ft. From S Line NW330 Ft. From E Line Quarter

1st. Report

Completion OCT 4 1950Remarks Nettie PoolKeyes Drlg. - Contr.Spudding Date 6-21-50Drlg. Data Oil well TD 35588" @ 200 Anhy 1360-90 Lens. 3258Simp. 3550 Arb. 3552 DST 3554-58open 1 hr. Rec. 250' oil 20 gr.5" @ 3554 TD 3558 FU 2400' oil 6 hr.S/ 200 bo 6 hr.Comp. 90 bopd 18% water

J. E. TYRA