


Section 33 Township 9 Range 17W  
Well No. 1 Westhusin  
Company Fred Haynes

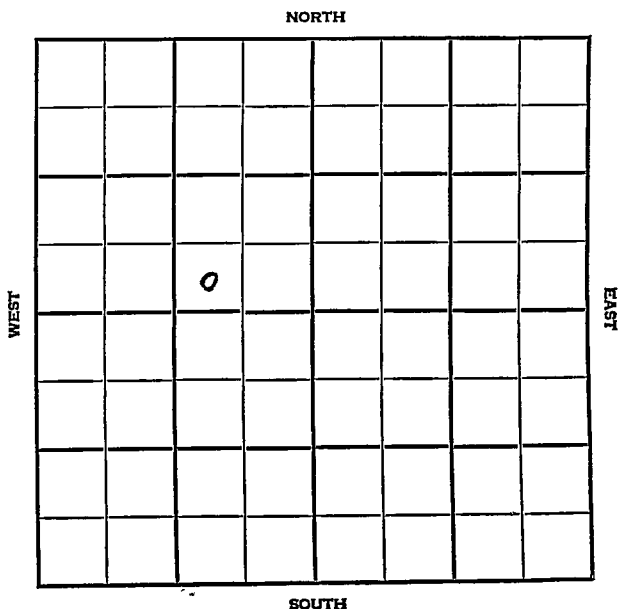

Rooks

KANSAS

|      |      |      |
|------|------|------|
| SEC. | TWP. | R.   |
| 33   | 9    | 17 W |

WELL NO.

# 1 Westhusin

FARM

COMPANY

Fred Haynes

CONTRACTOR

Shields

Nettie Pool


Ft. from N. Line

330 Ft. from S. Line

990 Ft. from E. Line

Ft. from W. Line

SW SE NW

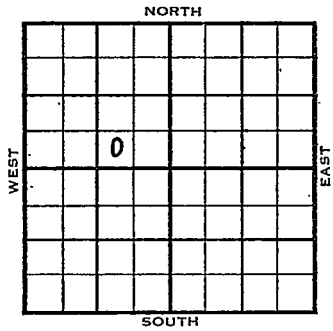

|      |           |        |
|------|-----------|--------|
|      | ELEVATION | REPORT |
| 1955 | 2107'     |        |

3/2

4/6

Spud 2-28-55

Spud 2-28-55, Oil well, TD 3546  
 8" @ 165, Anhy 1379; Heeb 3207,  
 Lans 3248, Arb 3541, TD 3543,  
 5" @ 3542 DE 3546, FU 1000'  
 12 hr,

Comp. 25 BOPD

**COMPLETED**

County **Rooks** State **National**

Sec. **33** (Blk. **9** (Sur. **17W** Map No.

Operator **Fred Haynes**

Well No. **1** Farm **Westhusin**

| Elev. | Location | SW | SE | NW |
|-------|----------|----|----|----|
|-------|----------|----|----|----|

0

FIRST REPORT

330 Ft. From S Line NW c

990 Ft. From E Line Quarter

1st. Report MAR 2 1955

### Completion

Remarks

Shields - Contr.

Spudding Date **2-28-55**

Drlg. Data

Nettie Pool

FABEN GILSTRAP

|         |               |                 |         |        |
|---------|---------------|-----------------|---------|--------|
| County  | Rooks         |                 | State   | Kansas |
| Sec. 33 | (Blk. Twp.) 9 | (Sur. Rge.) 17W | Map No. |        |

Operator Fred Haynes

Well No. 1 Farm Westhusin

|       |      |          |          |
|-------|------|----------|----------|
| Elev. | 2107 | Location | SW SE NW |
|-------|------|----------|----------|

330 Ft. From S Line NW

990 Ft. From E Line Quarter

1st. Report

Completion APR 6 1955

Remarks Nettie Pool

Shields - Contr.

Spudding Date 2-28-55

Drilg. Data      Oil well      TD 3546

8" @ 165    Anhy 1379    Heeb. 3207

Lans. 3248    Arb. 3541    TD 3543

5" @ 3542 DD 3546 FU 1000' oil 12 hr.

Comp. 25 bopd

FABEN GILSTRAP