

Rooks


KANSAS

SECTION 33 TOWNSHIP 9 RANGE 19W

WELL NO. #4 Richardson

COMPANY Mallonee Drlg.

NORTH

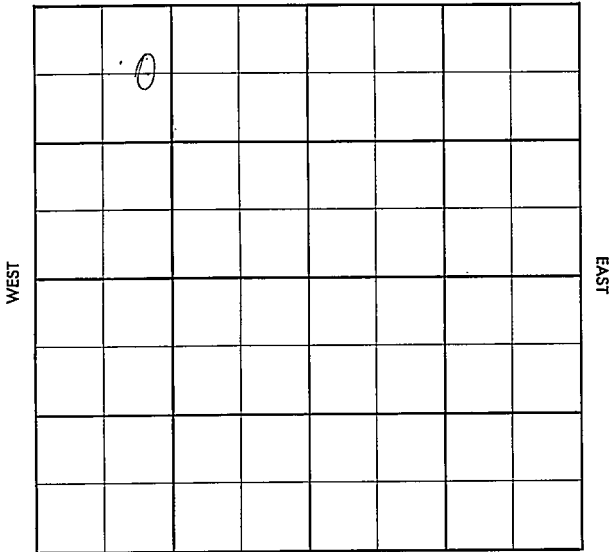

SOUTH

County Rooks Elev. 2227
 Sec. 33 Twp. 9 Rge. 19W
 Company Mallonee Drlg.
 FarmName Richardson No. 1

TOPS	DEPTH	LOG	DATUM
Anh.			
TP.			
H.			
Tr.			
Dg.			
BL.			
L.			
K.C.			
B.K.C.			
Ce.			
C.			
M.			
M.			
K.			
Mz.			
Mo.			
V.			
S.			
S.			
A.			
R.			
PE.			
G.			
T.D.			

Loc. in Sec. C E $\frac{1}{2}$ NW NW

Geol. _____
 Contr. Mallonee

Pool Gliak
Lynd

FIRST REPORT		
JAN 16 57		

Date Comm. 1-12-57
8" @ 188/150 drlg. 1650

[Handwritten signature]

Co.
L.S.
No.
Sec.
T.
R.

County Rocks Elev. 2227
 Sec. 33 Twp. 9 Rge. 10W
 Company Mallonee Drlg.
 Farm Name Richardson No. 4

TOPS	DEPTH	LOG	DATUM	Loc. in Sec.
Anh.				C E NW NW
Ep.				
H. <u>3403</u>	<u>3444</u>			
Tr.				
Dg.				
Bl.				
L. <u>3446</u>	<u>3447</u>			Geol.
K.C.				Contr.
B.K.C.	<u>3653</u>			<u>Mallonee</u>
Ce.				Pool <u>Glick</u>
C.	<u>3682</u>			Lined
M.				<div style="border: 1px solid black; padding: 5px; display: inline-block;"> <p>COMPLETE</p> <p>FEB 20 '57</p> </div>
M.				
K.				
Mz.				
Mo.				
V.				
S.	<u>3724</u>			
S.				
A.	<u>3753</u>			
R.				
PE.				
G.				
T.D.	<u>3756</u>			

Date Comm. 1-12-57
 8" @ 188/150 orig. 1650
3462 JAN 30 '57 9 1/2 3754/75'
 woct. DD 3759 T.D.
 7 Goph. no/w 300 ACID FEB 13 '57
 FO 2000 oil 12 hrs \$.51
 Boph no/w 2 hrs T.E.R.
 FEB 20 '57 P. 25 Bopd no/w.
 grav. 28°