


Section 23 Township 9 Range 20WWell No. #1 BruggemanCompany Virginia Drlg

Palco Pool NORTH

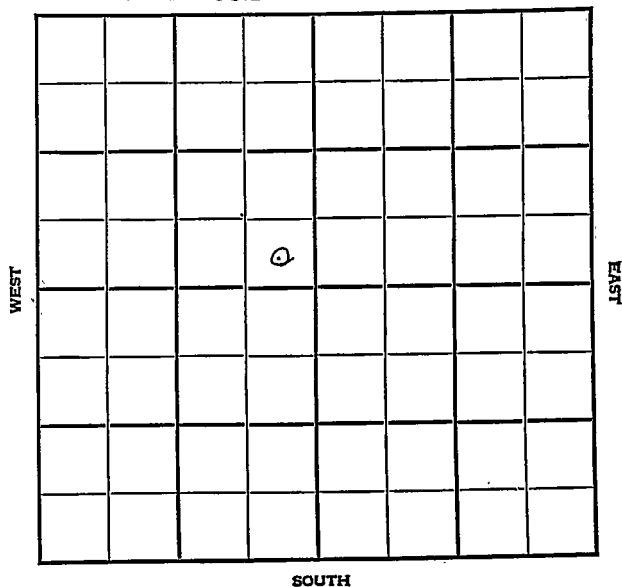

Sec. 33 Twp. 9 R. 20W

Well No. #1 Bruggeman Farm


Virginia Drlg. Company
Palco

 Ft. from N. Line

330 Ft. from S. Line

330 Ft. from E. Line

 Ft. from W. Line

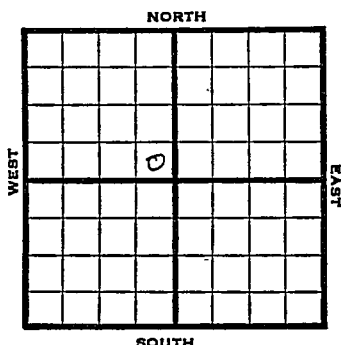

SE NW

1948

Elv. 2287' REPORT

4/14 Location

4/21 8" @ 135'
Drlg. 2110'

4/28 Drlg. 3687'

5/5 Lans. 3090'
Congl. 3836'
TD 3934 in Cong.

ABANDONED

Map No. _____ Sec. 33 Twp. 9 R. 20W

Well No. 1 Bruggeman

Virginia Drlg. Company

FIRST REPORT Contractor

SE NW

SECTION PLAT

_____ Ft. from N. Line

330 Ft. from S. Line

330 Ft. from E. Line

_____ Ft. from W. Line

	o		

Rooks County

Location X

Rig up _____

Drilling and Remarks:

RECORD

Cased _____ in., _____ ft.

Sand _____

Gas _____

Oil _____

Total Depth _____

PRODUCTION

1st 24 hrs. Nat. _____

1st 24 hrs. after shot _____

Gas _____ Cu. Ft.

Dry Hole _____

Abandoned _____

Date

APR 14 1948 19 S. J. LEWIS Scout

Map No. 65 Sec. 33 Twp. 9 R. 20W

Well No. 1 Bruggeman


Virginia Drlg. Company

ABANDONED

Contractor

SE NW

E 1, 2, 287
SECTION PLAT

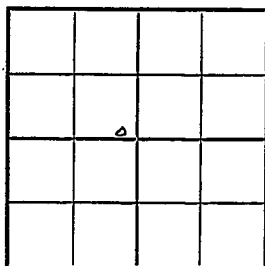

 Ft. from N. Line

330 Ft. from S. Line

330 Ft. from E. Line

 Ft. from W. Line

Rooks County

Location

Rig up

Drilling and Remarks:

Liams 3090
Cong 3836

RECORD

Cased 2 1/2 in., ft.

Sand

Gas

Oil

Total Depth 3934 in Cong

PRODUCTION

1st 24 hrs. Nat.

1st 24 hrs. after shot

Gas Cu. Ft.

Dry Hole

Abandoned

Date

MAY 5 1948 19 S. J. LEWIS Scout